


LE6 WCB NA083
12/01/2022

WATER WELL PLUGGING RECORD Form WWC-5P KSA 82a-1212 ID NO. 37746

1 **LOCATION OF WATER WELL:** Fraction \downarrow SW 1/4 SW 1/4 NE 1/4 NE-SE 1/4 Section Number 23 Township Number T 22 S Range Number 4 E W
County: Reno

Street/Rural Address of Well Location; if unknown, distance & direction from nearest town or intersection: If at owner's address, check here approximately 2.25 miles east and 0.75 miles south of Buhler, KS
Global Positioning Systems (GPS) information:
Latitude: 38.11947 (in decimal degrees)
Longitude: -97.72476 (in decimal degrees)
Elevation: _____
Horizontal Datum: WGS84, NAD83, NAD27
Collection Method: _____

2 **WATER WELL OWNER:** Albert G. Gaeddert Irrev. Trust
C/O Shirley A. Pestinger
RR#, St. Address, Box #: 1112 Terradyne
City, State ZIP Code: Andover, KS 67002
GPS unit (Make/Model): Garmin GPSmap 60CSx
 Digital Map/Photo, Topographic Map, Land Survey
Est. Accuracy: < 3 m, 3-5 m, 5-15 m, > 15 m

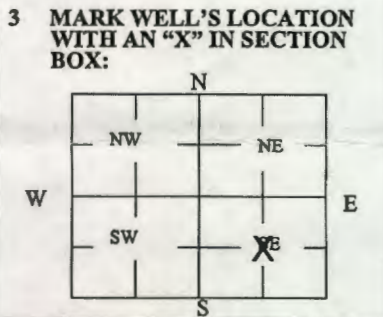

4 **DEPTH OF WELL** 165 ft.
WELL'S STATIC WATER LEVEL 27.6 ft
WELL WAS USED AS:
 Domestic Public Water Supply Dewatering
 Irrigation Oil Field Water Supply Monitoring
 Feedlot Domestic (Lawn & Garden) Injection Well
 Industrial Air Conditioning Other _____
Was a chemical/bacteriological sample submitted to Department? Yes No

5 **TYPE OF BLANK CASING USED:**
 Steel RMP (SR) Wrought Fiberglass Other (Specify below)
 PVC ABS Asbestos-Cement Concrete Tile
Blank casing diameter 16 in. Was casing pulled? Yes No If yes, how much _____
Casing height above or below land surface below 48 in.

6 **GROUT PLUG MATERIAL:** Neat cement Cement grout Bentonite Other _____
Grout Plug Intervals: From 27.6 ft. to 4 ft., From _____ ft. to _____ ft., From _____ ft. to _____ ft.

What is the nearest source of possible contamination:
 Septic tank Seepage pit Fuel storage Other (specify below)
 Sewer lines Pit privy Fertilizer storage
 Watertight sewer lines Sewage lagoon Insecticide storage
 Lateral lines Feedyard Abandoned water well Direction from well? West
 Cess pool Livestock pens Oil well/Gas well How many feet? approximately 30 ft.

FROM	TO	PLUGGING MATERIALS	FROM	TO	PLUGGING MATERIALS
165'	27.6'	Clean, coarse sand			Well plugging witnessed by
27.6'	4'	Cement grout			D. Randolph, GMD2 staff on 6/14/2022.
4'	0'	Topsoil			

7 **CONTRACTOR'S OR LANDOWNER'S CERTIFICATION:** This water well was plugged under my jurisdiction and was completed on (mo/day/year) 6/14/2022 and this record is true to the best of my knowledge and belief. Kansas Water Well Contractor's License No. 134. This Water Well Record was completed on (mo/day/year) 6/15/2022 under the business name of Darling Drilling Co. by (signature) Shirley A. Pestinger (trustee)

Send one white copy to Kansas Department of Health & Environment, Geology Section, 1000 SW Jackson Street, Ste. 420, Topeka, KS 66612-1367. Send one copy to WATER WELL OWNER and retain one for your records.
Visit us at <http://www.kdheks.gov/waterwell/index.html> Telephone 785-296-5524.

KSA82a-1212 **RECEIVED** Revised 1/20/2015

JUL 26 2022

EQUUS BEDS GMD #2