


1 LOCATION OF WATER WELL: Fraction Section Number Township Number Range Number
 COUNTY: HAMILTON NE 1/4 NW 1/4 NE 1/4 31 T 22 S R 40 W

Distance and direction from nearest town or city street address of well if located within city?
 FROM SYRACUSE, KS. - ON HIGHWAY 27 - 9 N NORTH AND 3/4 EAST

2 WATER WELL OWNER: ASHMORE, JOHN Board of Agriculture, Division of Water Resources
 RR#, St. Address, Box #: Application Number:
 City, State, ZIP code: SYRACUSE, KS 67878-

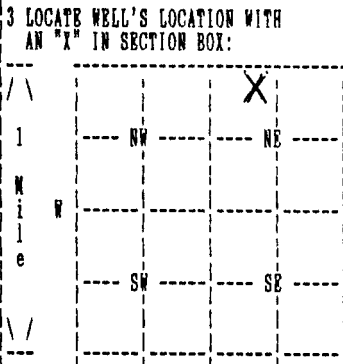

4 DEPTH OF COMPLETED WELL 605 ELEVATION: 0
 Depth(s) Groundwater Encountered 1. 0 ft. 2. 0 ft. 3. 0 ft.
 WELL'S STATIC WATER LEVEL 280 ft. below land surface measured on mo/day/yr 09/04/96
 Pump testdata: Well water was 0 ft. after 0 hours pumping 0 gpm
 Estimated Yield 35 gpm: Well water was 0 ft. after 0 hours pumping 0 gpm
 Bore Hole Diameter 9 in. to 605 ft., and in. to 0 ft.
 WELL WATER TO BE USED AS: DOMESTIC
 Was a chemical/bacteriological sample submitted to department? No;
 If yes, mo/day/yr sample was submitted Water well disinfected? Yes

5 TYPE OF BLANK CASING USED: PVC CASING JOINTS: GLUED
 Blank casing diameter 5 in. to 605 ft., Dia in. to 0 ft., Dia in. to 0 ft.
 Casing height above land surface 12 in., weight 0 lbs/ft. Wall thickness or gauge No. 17 13
 TYPE OF SCREEN OR PERFORATION MATERIAL: PVC
 SCREEN OR PERFORATION OPENINGS ARE: SAW CUT

SCREEN PERFORATED INTERVALS: From 500 ft. to 540 ft., From 0 ft. to 0 ft.
 GRAVEL PACK INTERVALS: From 560 ft. to 600 ft., From 0 ft. to 0 ft.
 From 40 ft. to 605 ft., From 0 ft. to 0 ft.
 From 0 ft. to 0 ft., From 0 ft. to 0 ft.

6 GROUT MATERIAL BENTONITE
 Grout Intervals: From 0 ft. to 40 ft., From 0 ft. to 0 ft., From 0 ft. to 0 ft.
 What is the nearest source of possible contamination: NONE - NEW SITE
 Direction from well? How many feet? 0

FROM	TO	LITHOLOGIC LOG	FROM	TO	PLUGGING INTERVALS
0	20	TOPSOIL PINE SAND			
20	40	PINE SAND CLAY PINE SAND			
40	60	COARSE SAND CLAY LIMESTONE			
60	80	LIMESTONE GRAY CLAY			
80	100	GRAY CLAY BLUE SHALE			
100	400	BLUE SHALE			
400	490	BLUE SHALE THIN ROCK LAYER			
490	580	SANDSTONE			
580	600	SANDSTONE GRAY CLAY			

7 CONTRACTOR'S OR LANDOWNER'S CERTIFICATION: This water well was Constructed under my jurisdiction and was completed on (mo/day/year) 09/06/96 and this record is true to the best of my knowledge and belief. Kansas Water Well Contractor's License No. 179 This Water Well Record was completed on (mo/day/yr) 09/13/96 under the business name of JOB'S WELL SERVICE, INC. by (signature) *Jacob Criss*