


WATER WELL RECORD Form WWC-5 KSA 82a-1212

1 LOCATION OF WELL: Fraction NW 1/4 NW 1/4 NE 1/4 Section Number 21 Township Number T 22 S Range Number R 40 W
 COUNTY: HAMILTON

Distance and direction from nearest town or city street address of well if located within city?
 FROM SYRACUSE - ON HIGHWAY 27 - 2 1/2 MILES EAST

2 WATER WELL OWNER: DIKEMAN, DARREL
 RR#, St. Address, Box #: 511 N. SUMNER Board of Agriculture, Division of Water Resources
 City, State, ZIP code: SYRACUSE, KS 67878- Application Number:

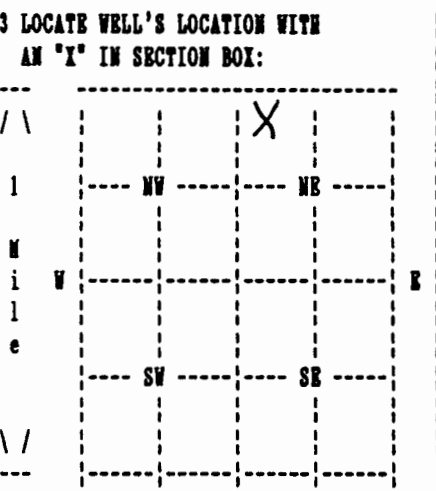

4 DEPTH OF COMPLETED WELL 225 ELEVATION: 0
 Depth(s) Groundwater Encountered 1. 0 ft. 2. 0 ft. 3. 0 ft.
 WELL'S STATIC WATER LEVEL 201 ft. below land surface measured on no/day/yr 05/09/06
 Pump test data: Well water was 0 ft. after 0 hours pumping 0 gpm
 Estimated Yield 12 gpm: Well water was 0 ft. after 0 hours pumping 0 gpm
 Bore Hole Diameter 10 in. to 225 ft., and in. to 0 ft.
 WELL WATER TO BE USED AS: DOMESTIC
 Was a chemical/bacteriological sample submitted to department? No;
 If yes, no/day/yr sample was submitted Water well disinfected? Yes

5 TYPE OF BLANK CASING USED: CERTA LOC CASIN CASING JOINTS: CERTA-LOC
 Blank casing diameter 5 in. to 225 ft., Dia in. to 0 ft., Dia in. to 0 ft.
 Casing height above land surface 12 in., weight 200 lbs/ft. Wall thickness or gauge No. 21
 TYPE OF SCREEN OR PERFORATION MATERIAL: PVC
 SCREEN OR PERFORATION OPENINGS ARE: SAW CUT

SCREEN PERFORATED INTERVALS: From 180 ft. to 220 ft., From 0 ft. to 0 ft.
 From 0 ft. to 0 ft., From 0 ft. to 0 ft.
 GRAVEL PACK INTERVALS: From 25 ft. to 225 ft., From 0 ft. to 0 ft.
 From 0 ft. to 0 ft., From 0 ft. to 0 ft.

6 GROUT MATERIAL BENTONITE
 Grout Intervals: From 5 ft. to 25 ft., From 0 ft. to 0 ft., From 0 ft. to 0 ft.
 What is the nearest source of possible contamination: NONE
 Direction from well? How many feet? 0

FROM	TO	LITHOLOGIC LOG	FROM	TO	PLUGGING INTERVALS
0	18	01 TOPSOIL 05 CLAY			
18	60	37 FIN-COAR SAN 38 SHAL-MED GRA			
60	78	37 FIN-COAR SAN 38 SHAL-MED GRA 18 LARGE			
78	100	32 TAN CLAY 10 FINE-MEDSAND 19 LAYERS			
100	120	10 FINE-MEDSAND			
120	160	10 FINE-MEDSAND 06 SMALL GRAVEL			
160	180	32 TAN CLAY			
180	218	37 FIN-COAR SAN 06 SMALL GRAVEL			
218	240	32 TAN CLAY 16 GRAY CLAY 07 BLUE SHALE			

7 CONTRACTOR'S OR LANDOWNER'S CERTIFICATION: This water well was Constructed under my jurisdiction and was completed on (no/day/year) 05/09/06 and this record is true to the best of my knowledge and belief. Kansas Water Well Contractor's License No. 179 This Water Well Record was completed on (no/day/yr) 05/24/06 under the business name of JOB'S WELL SERVICE, INC. by (signature) *Justin Cook*