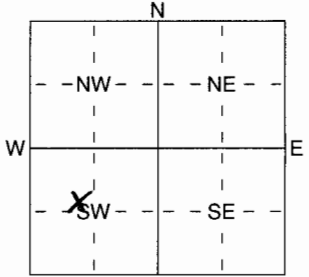


1 LOCATION OF WATER WELL: Fraction SE 1/4 NW 1/4 SW 1/4 Section Number 6 Township Number T 22 S Range Number R 5 EW
 County: Reno

Distance and direction from nearest town or city street address of well if located within city?
4 mi N of Hutchinson - 9800 N Plum

2 WATER WELL OWNER: Troy Selby
 RR#, St. Address, Box #: 19128 N Jackson Board of Agriculture, Division of Water Resources
 City, State, ZIP Code: Hutch, KS 67502 Application Number:

3 LOCATE WELL'S LOCATION WITH AN "X" IN SECTION BOX:

 4 DEPTH OF COMPLETED WELL 99 ft. ELEVATION:
 Depth(s) Groundwater Encountered 1 17 ft. 2 11-10-04 ft. 3 30 ft.
 WELL'S STATIC WATER LEVEL 17 ft. below land surface measured on 11-10-04
 Pump test data: Well water was 28 ft. after 2 hours pumping 30 gpm
 Est. Yield 30 gpm: Well water was 28 ft. after 2 hours pumping 30 gpm
 WELL WATER TO BE USED AS:
 Domestic 3 Feedlot 6 Oil field water supply 9 Dewatering 12 Other (Specify below)
 Irrigation 4 Industrial 7 Domestic (lawn & garden) 10 Monitoring well

5 TYPE OF BLANK CASING USED:
 Steel 3 RMP (SR) 5 Wrought iron 8 Concrete tile CASING JOINTS: Glued Clamped
 PVC 4 ABS 6 Asbestos-Cement 9 Other (specify below) Welded
 Blank casing diameter 5 in. to 77 ft., Dia 77 in. to 160 ft., Dia 160 in. to 160 ft.
 Casing height above land surface 12 in., weight 2.29 lbs./ft. Wall thickness or gauge No. 160
 TYPE OF SCREEN OR PERFORATION MATERIAL:
 Steel 3 Stainless Steel 5 Fiberglass PVC 10 Asbestos-Cement
 Brass 4 Galvanized Steel 6 Concrete tile 8 RMP (SR) 11 Other (Specify) 160
 9 ABS 12 None used (open hole)
 SCREEN OR PERFORATION OPENINGS ARE:
 Continuous slot 3 Mill slot 5 Gauzed wrapped Saw cut 11 None (open hole)
 Louvered shutter 4 Key punched 6 Wire wrapped 9 Drilled holes
 7 Torch cut 10 Other (specify) 160 ft.
 SCREEN-PERFORATED INTERVALS: From 77 ft. to 97 ft., From 97 ft. to 160 ft.
 GRAVEL PACK INTERVALS: From 23 ft. to 50 ft., From 50 ft. to 104 ft.

6 GROUT MATERIAL: 1 Neat cement 2 Cement grout Bentonite 4 Other 160
 Grout Intervals: From 3 ft. to 23 ft., From 50 ft. to 55 ft., From 55 ft. to 160 ft.
 What is the nearest source of possible contamination:
 Septic tank 4 Lateral lines 7 Pit privy 10 Livestock pens 14 Abandoned water well
 Sewer lines 5 Cess pool 8 Sewage lagoon 11 Fuel storage 15 Oil well/Gas well
 Watertight sewer lines 6 Seepage pit 9 Feedyard 12 Fertilizer storage 16 Other (specify below)
 Direction from well? How many feet?

FROM	TO	LITHOLOGIC LOG	FROM	TO	PLUGGING INTERVALS
0	19	F Sand			
19	27	Br + Gr Clay			
27	30	F Sand			
30	37	Br Clay			
37	41	F Sand			
41	70	Br Clay			
70	77	F Sand			
77	80	Br Clay			
80	101	F Sand			
101	104	Rocky Br + Gr Clay			

7 CONTRACTOR'S OR LANDOWNER'S CERTIFICATION: This water well was constructed, (2) reconstructed, or (3) plugged under my jurisdiction and was completed on (mo/day/year) 11-10-04 and this record is true to the best of my knowledge and belief. Kansas Water Well Contractor's Licence No 447 This Water Well Record was completed on (mo/day/yr) 12-2-04 under the business name of Miller Drilling by (signature) G Miller

INSTRUCTIONS: Use typewriter or ball point pen. PLEASE PRESS FIRMLY and PRINT clearly. Please fill in blanks, underline or circle the correct answers. Send top three copies to Kansas Department of Health and Environment, Bureau of Water, Geology Section, 1000 SW Jackson St., Suite 420, Topeka, Kansas 66612-1367. Telephone 785-296-5522. Send one to WATER WELL OWNER and retain one for your records. Fee of \$5.00 for each constructed well.