


1 LOCATION OF WATER WELL: County: Renov Fraction: NE 1/4 NW 1/4 Section Number: 19 Township Number: T 22 S Range Number: R 5 E/W

Distance and direction from nearest town or city street address of well if located within city?
1/4 East of Plum on 69th

2 WATER WELL OWNER: 609 E 9th Ave Mena
 RR#, St. Address, Box #: 609 E 9th Ave
 City, State, ZIP Code: Mena, KS 67502
 Board of Agriculture, Division of Water Resources
 Application Number:

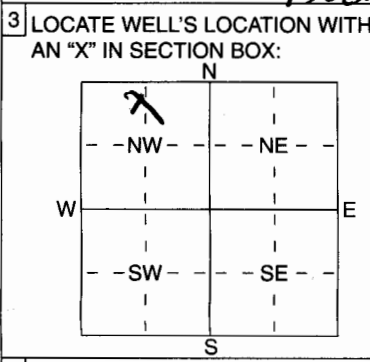

4 DEPTH OF COMPLETED WELL ft. ELEVATION: ft.

Depth(s) Groundwater Encountered 14 ft. 2 ft. 3 ft.

WELL'S STATIC WATER LEVEL 14 ft. below land surface measured on 9-16-01 mo/day/yr

Pump test data: Well water was ft. after hours pumping gpm

Est. Yield gpm: Well water was ft. after hours pumping gpm

WELL WATER TO BE USED AS:

1 Domestic	3 Feedlot	5 Public water supply	8 Air conditioning	11 Injection well
2 Irrigation	4 Industrial	6 Oil field water supply	9 Dewatering	12 Other (Specify below)
		<u>7</u> Domestic (lawn & garden)	10 Monitoring well	

Was a chemical/bacteriological sample submitted to Department? Yes No; If yes, mo/day/yr sample was submitted
 Water Well Disinfected? Yes No

5 TYPE OF BLANK CASING USED:

1 Steel	3 RMP (SR)	5 Wrought iron	8 Concrete tile	CASING JOINTS: <u>Glued</u> Clamped
<u>2 PVC</u>	4 ABS	6 Asbestos-Cement	9 Other (specify below)	<u>Welded</u>
		7 Fiberglass		Threaded

Blank casing diameter 5" in. to 56 ft., Dia in. to ft., Dia in. to ft.

Casing height above land surface 17 in., weight lbs./ft. Wall thickness or gauge No. SOR 26

TYPE OF SCREEN OR PERFORATION MATERIAL:

1 Steel	3 Stainless Steel	5 Fiberglass	<u>PVC</u>	10 Asbestos-Cement
2 Brass	4 Galvanized Steel	6 Concrete tile	8 RMP (SR)	11 Other (Specify)
			9 ABS	12 None used (open hole)

SCREEN OR PERFORATION OPENINGS ARE:

1 Continuous slot	3 Mill slot	5 Gauzed wrapped	<u>8 Saw cut</u>	11 None (open hole)
2 Louvered shutter	4 Key punched	6 Wire wrapped	9 Drilled holes	
		7 Torch cut	10 Other (specify) ft.	

SCREEN-PERFORATED INTERVALS: From 56 ft. to 76 ft., From ft. to ft.

GRAVEL PACK INTERVALS: From 50 ft. to 76 ft., From ft. to ft.

6 GROUT MATERIAL: 1 Neat cement 2 Cement grout 3 Bentonite 4 Other

Grout Intervals: From 0 ft. to 20 ft., From ft. to ft., From ft. to ft.

What is the nearest source of possible contamination:

1 Septic tank	4 Lateral lines	7 Pit privy	10 Livestock pens	<u>14</u> Abandoned water well
2 Sewer lines	5 Cess pool	8 Sewage lagoon	11 Fuel storage	15 Oil well/Gas well
3 Watertight sewer lines	6 Seepage pit	9 Feedyard	12 Fertilizer storage	16 Other (specify below)
			13 Insecticide storage	

Direction from well? West How many feet? 39

FROM	TO	LITHOLOGIC LOG	FROM	TO	PLUGGING INTERVALS
0	4	Sand Fine			
4	10	Clay			
10	14	Sand			
14	35	Clay			
35	76	Sand & Clay			
56	76	Sand			
76		Clay			

7 CONTRACTOR'S OR LANDOWNER'S CERTIFICATION: This water well was (1) constructed, (2) reconstructed, or (3) plugged under my jurisdiction and was completed on (mo/day/year) 9-16-01 and this record is true to the best of my knowledge and belief. Kansas Water Well Contractor's Licence No. 440 This Water Well Record was completed on (mo/day/yr) 02-02-05
 Business name of Carl Vincent Sr by (signature) [Signature]

INSTRUCTIONS: Use typewriter or ball point pen. PLEASE PRESS FIRMLY and PRINT clearly. Please fill in blanks, underline or circle the correct answers. Send top three copies to Kansas Department of Health and Environment, Bureau of Water, Geology Section, 1000 SW Jackson St., Suite 420, Topeka, Kansas 66612-1367. Telephone 785-296-5522. Send one to WATER WELL OWNER and retain one for your records. Fee of \$5.00 for each constructed well.