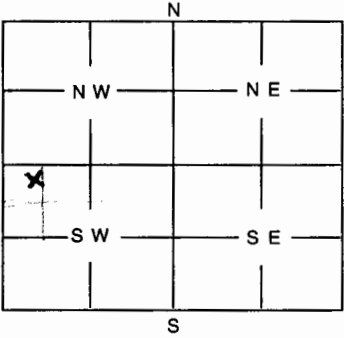


| 1   | LOCATION OF WATER WELL:<br>County: <u>Reno</u>   | Fraction<br><u>NE 1/4 NW 1/4 SW 1/4</u> | Section Number<br><u>33</u>     | Township Number<br><u>22</u> | Range Number<br><u>5W</u> |               |                       
|---|---|-----------------------------------------|---------------------------------|------------------------------|---------------------------|---------------|-----------------------|--------------------|---------------------------------|--------------------------|--------------------|-----------------------|----------------------------|--------------------------|---------------------|------------------------|---------------------|-----------------|------------|-------------------------|--|-------------|-------------------|----------------------|--|--|--|--|--|
| Distance and direction from nearest town or city street address of well if located within city?<br><u>WESTAR ENERGY- HUTCHINSON, KS.</u>   |   |                                         
| 2   | WATER WELL OWNER: <u>WESTAR ENERGY</u><br>RR #, St. Address, Box #: <u>818 SOUTH KANSAS AVE.</u><br>City, State, ZIP Code : <u>TOPEKA, KS. 66612</u><br>Board of Agriculture, Division of Water Resources<br>Application Number: <u>4240</u>   |                                         |                                 
| 3   | MARK WELL'S LOCATION WITH AN "X" IN SECTION BOX:<br><div style="text-align: center;">  </div>   |                                         |                                 
| 4   | DEPTH OF WELL ..... <u>55</u> ..... ft<br>WELL'S STATIC WATER LEVEL ..... <u>14</u> ..... ft.<br>WELL WAS USED AS:<br><table style="width:100%;"> <tr> <td>1 Domestic</td> <td>5 Public Water Supply</td> <td>9 Dewatering</td> </tr> <tr> <td>2 Irrigation</td> <td>6 Oil Field Water Supply</td> <td>10 Monitoring Well</td> </tr> <tr> <td>3 Feedlot</td> <td>7 Domestic (Lawn &amp; Garden)</td> <td>11 Injection Well</td> </tr> <tr> <td>4 <u>Industrial</u></td> <td>8 Air Conditioning</td> <td>12 Other .....</td> </tr> </table> Was a chemical / bacteriological sample submitted to Department? Yes ..... No <u>X</u> .....<br>If yes, mo/day/yr sample was submitted .....<br>Water Well Disinfected: Yes <u>X</u> ..... No .




| 5   | TYPE OF BLANK CASING USED:<br>1 Steel    3 RMP (SR)    5 Wrought    7 Fiberglass    9 Other (Specify below)<br>2 PVC    4 ABS    6 <u>Asbestos-Cement</u> 8 Concrete Tile<br>Blank casing diameter ..... <u>22</u> ..... in.    Was casing pulled? Yes ..... No <u>X</u> ..... If yes, how much .....<br>Casing height above or below land surface ..... <u>24</u> ..... in.   |                                         |                                 
| 6   | GROUT PLUG MATERIAL:    1 Neat cement    2 <u>Cement grout</u> 3 Bentonite    4 <u>Other</u> <u>Hole Plug - Sand</u><br>Grout Plug Intervals:    From ..... ft. to ..... ft.,    From ..... ft. to ..... ft.,    From ..... ft. to ..... ft.<br>What is the nearest source of possible contamination:<br><table style="width:100%;"> <tr> <td>1 Septic tank</td> <td>6 Seepage pit</td> <td>11 Fuel storage</td> <td>16 <u>Other (specify below)</u></td> </tr> <tr> <td>2 Sewer lines</td> <td>7 Pit privy</td> <td>12 Fertilizer storage</td> <td><u>WATER WELL</u></td> </tr> <tr> <td>3 Watertight sewer lines</td> <td>8 Sewage lagoon</td> <td>13 Insecticide storage</td> <td></td> </tr> <tr> <td>4 Lateral lines</td> <td>9 Feedyard</td> <td>14 Abandoned water well</td> <td></td> </tr> <tr> <td>5 Cess Pool</td> <td>10 Livestock pens</td> <td>15 Oil well/Gas well</td> <td></td> </tr> </table> Direction from well? <u>North</u> .....    How many feet? <u>32</u> ..... |                                         |                                 |                              |                           | 





| <table border="1" style="width:100%; border-collapse: collapse;"> <thead> <tr> <th style="width:10%;">FROM</th> <th style="width:10%;">TO</th> <th style="width:80%;">PLUGGING MATERIALS</th> </tr> </thead> <tbody> <tr> <td><u>0</u></td> <td><u>2</u></td> <td><u>DIRT</u></td> </tr> <tr> <td><u>2</u></td> <td><u>4</u></td> <td><u>HOLE PLUG</u></td> </tr> <tr> <td><u>4</u></td> <td><u>14</u></td> <td><u>CEMENT GROUT</u></td> </tr> <tr> <td><u>14</u></td> <td><u>55</u></td> <td><u>SAND</u></td> </tr> <tr><td> </td><td> </td><td> </td></tr> <tr><td> </td><td> </td><td> </td></tr> <tr><td> </td><td> </td><td> </td></tr> </tbody> </table> |   |                                         |                                 |                              |                           | FROM          | TO                    | PLUGGING MATERIALS | 





|   |   
| 7   | CONTRACTOR'S OR LANDOWNER'S CERTIFICATION: This water well was plugged under my jurisdiction and was completed on (mo/day/year) ..... <u>4-13-05</u> ..... and this record is true to the best of my knowledge and belief. Kansas Water Well Contractor's License No. <u>134</u><br><u>4-29-05</u> under the business name of <u>Basinchanty Bemis Ent.</u><br>by (signature) <u>James Doleman</u> This Water Well Record was completed on (mo/day/year) .....   |                                         |                                 
| INSTRUCTIONS: Use typewriter or ball point pen. Please press firmly and print clearly. Please fill in blanks, underline or circle the correct answers. Send top three copies to Kansas Department of Health and Environment, Bureau of Water, Topeka, Kansas 66620-0001. Telephone: 785/296-3565. Send one to Water Well Owner and retain one for your records.   |   |                                         