


1 LOCATION OF WATER WELL: Fraction NW 1/4 NE 1/4 NW 1/4 Section Number 18 Township Number T 22 S Range Number R 5 E  
 County: Reno

Distance and direction from nearest town or city street address of well if located within city?  
3 mi N of Hutchinson - 710 Rollingdunes S well

2 WATER WELL OWNER: Mike Miller - Borecky  
 RR#, St. Address, Box #: 710 Rollingdunes Board of Agriculture, Division of Water Resources  
 City, State, ZIP Code: Hutch, KS 67502 Application Number:

3 LOCATE WELL'S LOCATION WITH AN "X" IN SECTION BOX: 4 DEPTH OF COMPLETED WELL 88 ft. ELEVATION: \_\_\_\_\_

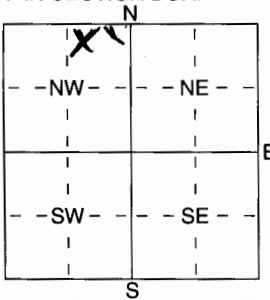

Depth(s) Groundwater Encountered 1 \_\_\_\_\_ ft. 2 \_\_\_\_\_ ft. 3 \_\_\_\_\_ ft.  
 WELL'S STATIC WATER LEVEL 7 ft. below land surface measured on mo/day/yr 8-24-05  
 Pump test data: Well water was 27 ft. after 2 hours pumping 25 gpm  
 Est. Yield \_\_\_\_\_ gpm: Well water was \_\_\_\_\_ ft. after \_\_\_\_\_ hours pumping \_\_\_\_\_ gpm  
 WELL WATER TO BE USED AS:  
 Domestic 3 Feedlot 6 Oil field water supply 9 Dewatering 12 Other (Specify below)  
 Irrigation 4 Industrial 7 Domestic (lawn & garden) 10 Monitoring well

Was a chemical/bacteriological sample submitted to Department? Yes \_\_\_\_\_ No ; If yes, mo/day/yrs sample was submitted  
 Water Well Disinfected?  Yes  No

5 TYPE OF BLANK CASING USED:  
 Steel 3 RMP (SR) 5 Wrought iron 8 Concrete tile CASING JOINTS: Glued  Clamped \_\_\_\_\_  
 PVC 4 ABS 7 Fiberglass \_\_\_\_\_ Welded \_\_\_\_\_  
 Blank casing diameter 5 in. to 6.8 ft., Dia \_\_\_\_\_ in. to \_\_\_\_\_ ft., Dia \_\_\_\_\_ in. to \_\_\_\_\_ ft.

Casing height above land surface 12 in., weight 2.29 lbs./ft. Wall thickness or gauge No. 160  
 TYPE OF SCREEN OR PERFORATION MATERIAL:  
 Steel 3 Stainless Steel 5 Fiberglass  PVC 10 Asbestos-Cement  
 Brass 4 Galvanized Steel 6 Concrete tile 8 RMP (SR) 11 Other (Specify) \_\_\_\_\_  
 Screen or perforation openings are: 9 ABS 12 None used (open hole)

SCREEN OR PERFORATION OPENINGS ARE:  
 Continuous slot 3 Mill slot 5 Guazed wrapped  Saw cut 11 None (open hole)  
 Louvered shutter 4 Key punched 6 Wire wrapped 9 Drilled holes  
 \_\_\_\_\_ 7 Torch cut 10 Other (specify) \_\_\_\_\_ ft.

SCREEN-PERFORATED INTERVALS: From 68 ft. to 88 ft., From \_\_\_\_\_ ft. to \_\_\_\_\_ ft.  
 From \_\_\_\_\_ ft. to \_\_\_\_\_ ft., From \_\_\_\_\_ ft. to \_\_\_\_\_ ft.  
 GRAVEL PACK INTERVALS: From 23 ft. to 50 ft., From \_\_\_\_\_ ft. to \_\_\_\_\_ ft.  
 From 55 ft. to 91 ft., From \_\_\_\_\_ ft. to \_\_\_\_\_ ft.

6 GROUT MATERIAL: 1 Neat cement 2 Cement grout  Bentonite 4 Other \_\_\_\_\_  
 Grout Intervals: From 3 ft. to 23 ft., From 50 ft. to 55 ft., From \_\_\_\_\_ ft. to \_\_\_\_\_ ft.

What is the nearest source of possible contamination:  
 Septic tank 4 Lateral lines 7 Pit privy 10 Livestock pens 14 Abandoned water well  
 Sewer lines 5 Cess pool 8 Sewage lagoon 11 Fuel storage 15 Oil well/Gas well  
 Watertight sewer lines 6 Seepage pit 9 Feedyard 12 Fertilizer storage  Other (specify below) pond  
 Direction from well? E How many feet? 80

FROM	TO	LITHOLOGIC LOG	FROM	TO	PLUGGING INTERVALS
0	5	F Sand			
5	11	Br + Gr Clay			
11	19	F Sand			
19	42	Br + Gr Clay			
42	45	F Sand			
45	59	Br + Gr Clay			
59	68	Very sandy clay			
68	87	F Sand			
87	91	Br Clay			

7 CONTRACTOR'S OR LANDOWNER'S CERTIFICATION: This water well was  constructed, (2) reconstructed, or (3) plugged under my jurisdiction and was completed on (mo/day/year) 8-24-05 and this record is true to the best of my knowledge and belief. Kansas Water Well Contractor's Licence No 447 This Water Well Record was completed on (mo/day/yr) 9-20-05 under the business name of Miller Drilling by (signature) [Signature]