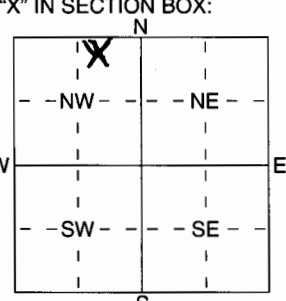


1 LOCATION OF WATER WELL: Fraction NW 1/4 NE 1/4 NW 1/4 Section Number 18 Township Number T 22 S Range Number R 5 E/W
 County: Reno

Distance and direction from nearest town or city street address of well if located within city?
3 mi N of Hutchinson - 710 Rollingdunes N well

2 WATER WELL OWNER: Mike Miller - Borecky
 RR#, St. Address, Box # : 710 Rollingdunes Board of Agriculture, Division of Water Resources
 City, State, ZIP Code : Hutch, KS 67502 Application Number:

3 LOCATE WELL'S LOCATION WITH AN "X" IN SECTION BOX:

 4 DEPTH OF COMPLETED WELL 8.7 ft. ELEVATION:
 Depth(s) Groundwater Encountered 1 ft. 2 ft. 3 ft.
 WELL'S STATIC WATER LEVEL 8 ft. below land surface measured on mo/day/yr 8-25-05
 Pump test data: Well water was 2.5 ft. after 2 hours pumping 2.5 gpm
 Est. Yield gpm: Well water was ft. after hours pumping gpm
 WELL WATER TO BE USED AS: 5 Public water supply Air conditioning 11 Injection well
 1 Domestic 3 Feedlot 6 Oil field water supply 9 Dewatering 12 Other (Specify below)
 2 Irrigation 4 Industrial 7 Domestic (lawn & garden) 10 Monitoring well
 Was a chemical/bacteriological sample submitted to Department? Yes No X ; If yes, mo/day/yr sample was submitted
 Water Well Disinfected? Yes No

5 TYPE OF BLANK CASING USED: 5 Wrought iron 8 Concrete tile CASING JOINTS: Glued X Clamped
 1 Steel 3 RMP (SR) 6 Asbestos-Cement 9 Other (specify below) Welded
 PVC 4 ABS 7 Fiberglass Threaded
 Blank casing diameter 5 in. to 6.7 ft. Dia in. to ft. Dia in. to ft.
 Casing height above land surface 1.2 in., weight 2.29 lbs./ft. Wall thickness or gauge No. 160
 TYPE OF SCREEN OR PERFORATION MATERIAL: PVC 10 Asbestos-Cement
 1 Steel 3 Stainless Steel 5 Fiberglass 8 RMP (SR) 11 Other (Specify)
 2 Brass 4 Galvanized Steel 6 Concrete tile 9 ABS 12 None used (open hole)
 SCREEN OR PERFORATION OPENINGS ARE: 5 Gauzed wrapped Saw cut 11 None (open hole)
 1 Continuous slot 3 Mill slot 6 Wire wrapped 9 Drilled holes
 2 Louvered shutter 4 Key punched 7 Torch cut 10 Other (specify) ft.
 SCREEN-PERFORATED INTERVALS: From 6.7 ft. to 8.7 ft., From ft. to ft.
 GRAVEL PACK INTERVALS: From 2.3 ft. to 5.0 ft., From ft. to ft.
 From 5.5 ft. to 9.2 ft., From ft. to ft.

6 GROUT MATERIAL: 1 Neat cement 2 Cement grout Bentonite 4 Other
 Grout Intervals: From 3 ft. to 2.3 ft., From 5.0 ft. to 5.5 ft., From ft. to ft.
 What is the nearest source of possible contamination:
 1 Septic tank 4 Lateral lines 7 Pit privy 10 Livestock pens 14 Abandoned water well
 2 Sewer lines 5 Cess pool 8 Sewage lagoon 11 Fuel storage 15 Oil well/Gas well
 3 Watertight sewer lines 6 Seepage pit 9 Feedyard 12 Fertilizer storage Other (specify below)
 3 Watertight sewer lines 6 Seepage pit 9 Feedyard 13 Insecticide storage pand
 Direction from well? E How many feet? 80

FROM	TO	LITHOLOGIC LOG	FROM	TO	PLUGGING INTERVALS
0	5	F Sand			
5	11	Br Clay			
11	20	F Sand			
20	43	Br + Gr Clay			
43	45	F Sand			
45	59	Br + Gr Clay			
59	67	Very Sandy Clay			
67	85	F Sand			
85	92	Br Clay			

7 CONTRACTOR'S OR LANDOWNER'S CERTIFICATION: This water well was constructed, (2) reconstructed, or (3) plugged under my jurisdiction and was completed on (mo/day/year) 8-25-05 and this record is true to the best of my knowledge and belief. Kansas Water Well Contractor's Licence No. 8-447 This Water Well Record was completed on (mo/day/yr) 9-20-05 under the business name of Miller Drilling by (signature) E Miller