

## WATER WELL PLUGGING RECORD Form WWC-5P

KSA 82a-1212

ID NO.

## 1 LOCATION OF WATER WELL:

County:

Reno

Fraction

NW 1/4 NW 1/4 NW 1/4

Section Number

30

Township Number

22

Range Number

5 E

Distance and direction from nearest town or city street address of well if located within city?

701 E 56 ST, Hutchinson

## 2 WATER WELL OWNER:

Duane Ely

RR#, St. Address, Box #:

1429 Karmold

City, State ZIP Code:

Lawrence, KS 66049

Global Positioning Systems (decimal degrees, min. of 4 digits)

Latitude: 38.11488


Longitude: 97.91779

Elevation:

Datum: NAD 83

Data Collection Method:

## 3 MARK WELL'S LOCATION WITH AN "X" IN SECTION BOX:

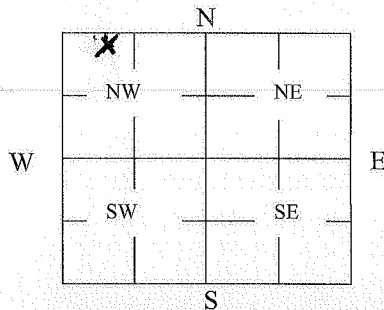

## 4 DEPTH OF WELL 43 ft.

WELL'S STATIC WATER LEVEL 11 ft

WELL WAS USED AS:

☒ Domestic

2 Irrigation

3 Feedlot

4 Industrial

5 Public Water Supply

6 Oil Field Water Supply

7 Domestic (Lawn &amp; Garden)

8 Air Conditioning

9 Dewatering

10 Monitoring

11 Injection Well

12 Other

Was a chemical/bacteriological sample submitted to Department? Yes No

## 5 TYPE OF BLANK CASING USED:

1 Steel

☒ RMP (SR)

5 Wrought

7 Fiberglass

9 Other (Specify below)

2 PVC

4 ABS

6 Asbestos-Cement

8 Concrete Tile

Blank casing diameter 6 in. Was casing pulled? Yes No X If yes, how much

Casing height above or below land surface 36 in.

## 6 GROUT PLUG MATERIAL:

1 Neat cement

2 Cement grout

☒ Bentonite

4 Other

Grout Plug Intervals: From 3 ft. to 12 ft., From ft. to ft., From to ft.

What is the nearest source of possible contamination:

1 Septic tank

6 Seepage pit

11 Fuel Storage

16 Other (specify below)

2 Sewer lines

7 Pit privy

12 Fertilizer storage

3 Watertight sewer lines

8 Sewage lagoon

13 Insecticide storage

4 Lateral lines

9 Feedyard

14 Abandoned water well

Direction from well?

5 Cess pool

10 Livestock pens

15 Oil well/Gas well

How many feet?

FROM	TO	PLUGGING MATERIALS	FROM	TO	PLUGGING MATERIALS
0	3	Fill Dirt			
3	12	Bentonite			
12	43	Sand & Gravel			

7 CONTRACTOR'S OR LANDOWNER'S CERTIFICATION: This water well was plugged under my jurisdiction and was completed on (mo/day/year) 5-18-13 and this record is true to the best of my knowledge and belief. Kansas Water Well Contractor's License No. 44. This Water Well Record was completed on (mo/day/year) 5-23-13 under the business name of Miller Drilling by (signature) J. Miller

INSTRUCTIONS: Use typewriter or ballpoint pen. Please press firmly and print clearly. Please fill in blanks, underline or circle the correct answers. Send top three copies to Kansas Department of Health and Environment, Bureau of Water, Geology Section, 1000 SW Jackson St., Ste. 420, Topeka, Kansas 66612-1367. Telephone: 785/296-5522. Send one to Water Well Owner and retain one for your records. Visit us at <http://www.kdheks.gov/geo/waterwells>.