

CORRECTION(S) TO WATER WELL RECORD (WWC-5)

(to rectify lacking or incorrect information)

County: reno

Location listed as:

Section-Township-Range: 10-22-4W

Fraction (  $\frac{1}{4}$   $\frac{1}{4}$   $\frac{1}{4}$  ): SW SW SW

Location changed to:

10-22 S-5W

SW SW SW

Other changes: Initial statements: \_\_\_\_\_

Changed to: \_\_\_\_\_

Comments: \_\_\_\_\_

verification method: (corrected per driller's directions; map on internet and

KS. county maps.

initials: E.P. date: 6/20/2007


USE TYPEWRITER OR BALL POINT PEN-PRESS FIRMLY, PRINT CLEARLY.

WATER WELL RECORD  
KSA 82a-1201-1215

Kansas Department of Health and Environment-Division of Environment  
(Water well Contractors)  
Topeka, Kansas 66620

1. Location of well: County Ren0 Fraction SW 1/4 SW 1/4 SW 1/4 Section number 10 Township number T 22 S R 4 EW

2. Distance and direction from nearest town or city: 1/2 mi medora  
Street address of well location if in city: 3/4 West U side  
3. Owner of well: Tom Manche  
R.R. or street: R.R. 5, No. 306  
City, state, zip code: Hutchinson, Kansas 67501

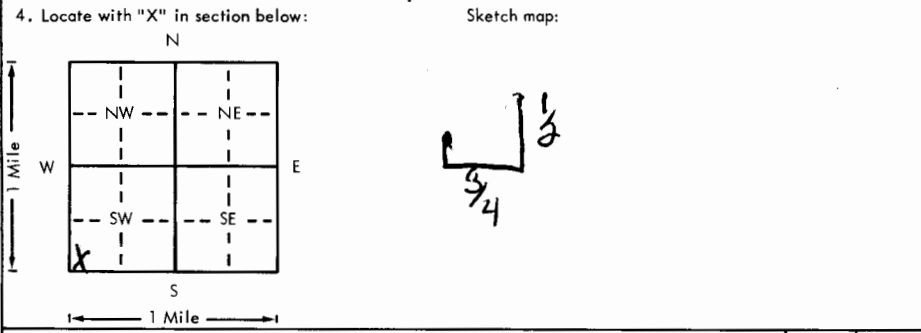

6. Bore hole dia. 10 in. Completion date: Oct. 12, 1979  
Well depth 65 ft.  
7.  Cable tool  Rotary  Driven  Dug  
 Hollow rod  Jetted  Bored  Reverse rotary  
8. Use:  Domestic  Public supply  Industry  
 Irrigation  Air conditioning  Stock  
 Lawn  Oil field water  Other  
9. Casing: Material PVC Height: Above or below  
Threaded  Welded  Surface 18 in.  
RMP  PVC  Weight 160 lbs./ft.  
Dia. 5 in. to 0 ft. depth Wall Thickness: inches or  
Dia. 5 in. to 15 ft. depth gage No. 258

5. Type and color of material	From	To
Top Soil	0	3
Clay	3	17
Fine Sand	17	22
Clay	22	49
Fine Sand	49	55
Clay	55	58
Fine Sand	58	65
(Use a second sheet if needed)		

10. Screen: Manufacturer's name Certain-Feed  
Type Sawed Dia. 5  
Slot/gauze 1/16 Length 20  
Set between 45 ft. and 65 ft.  
Gravel pack? yes Size range of material 1/4 - 1/8  
11. Static water level: 14 ft. below land surface Date 10-12-79 mo./day/yr.  
12. Pumping level below land surfaces:  
18 ft. after 1 hrs. pumping 20 g.p.m.  
     ft. after      hrs. pumping      g.p.m.  
Estimated maximum yield 25 g.p.m.  
13. Water sample submitted:      mo./day/yr.  
 Yes  No Date       
14. Well head completion:  
 Pitless adapter 18 Inches above grade  
15. Well grouted? Yes  
With:  Neat cement  Bentonite  Concrete  
Depth: From 0 ft. to 10 ft.  
16. Nearest source of possible contamination:  
ft.      Direction none Type       
Well disinfected upon completion?  Yes  No  
17. Pump:  Not installed  
Manufacturer's name       
Model number      HP      Volts       
Length of drop pipe      ft. capacity      g.p.m.  
Type:  
 Submersible  Turbine  
 Jet  Reciprocating  
 Centrifugal  Other

18. Elevation:       
19. Remarks:       
Topography:  
 Hill  
 Slope  
 Upland  
 Valley

20. Water well contractor's certification:  
This well was drilled under my jurisdiction and this report is true to the best of my knowledge and belief.  
Rosencrantz, Bellis Ent. Inc., 1314  
Business name      License No.       
Address 1211 W. 4th, Hutch. Kans.  
Signed Mike Flaws Date 11-7-79  
Authorized representative