

WATER WELL RECORD


Form WWC-5

Division of Water Resources App. No.

1 LOCATION OF WATER WELL: County: Reno -DRL Fraction 1/4 NW 1/4 SE 1/4 SE 1/4 Section Number 31 Township No. T22S Range Number R5 E1W

Street/Rural Address of Well Location; if unknown, distance & direction from nearest town or intersection: If at owner's address, check here X Global Positioning System (GPS) information: Latitude: Longitude: Elevation:

2 WATER WELL OWNER: Lucy Weber 3306 Amanda St Hutchinson, KS 67502 Collection Method: GPS unit (Make/Model: Digital Map/Photo, Topographic Map, Land Survey Est. Accuracy: <3 m, 3-5 m, 5-15 m, >15 m

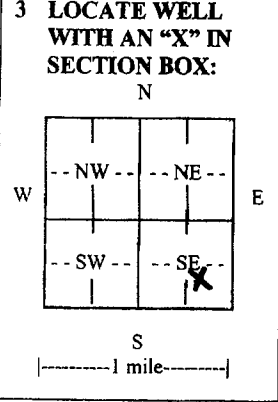

3 LOCATE WELL WITH AN 'X' IN SECTION BOX: 4 DEPTH OF COMPLETED WELL 32 ft. Depth(s) Groundwater Encountered (1) 14.5 ft. (2) 14.5 ft. (3) 14.5 ft. WELL'S STATIC WATER LEVEL 14.5 ft. below land surface measured on mo/day/yr 10-14-16 Pump test data: Well water was 14.5 ft. after 1/2 hours pumping 25 gpm EST. YIELD gpm Well water was ft. after hours pumping gpm Bore Hole Diameter in. to 14 ft. and in. to ft. WELL WATER TO BE USED AS: Public water supply Geothermal Injection well Domestic Feedlot Oil field water supply Dewatering Other (Specify below) Irrigation Industrial Domestic-lawn & garden Monitoring well Was a chemical/bacteriological sample submitted to Department? Yes X No If yes, mo/day/yr sample was submitted. Water well disinfected? X Yes No

5 TYPE OF CASING USED: Steel X PVC Other CASING JOINTS: X Glued Clamped Welded Threaded Casing diameter 5 in. to 32 ft., Diameter in. to ft., Diameter in. to ft. Casing height above land surface 12 in., Weight 229 lbs./ft., Wall thickness or gauge No. 160 TYPE OF SCREEN OR PERFORATION MATERIAL: Steel Stainless Steel X PVC Other (Specify) Brass Galvanized Steel None used (open hole) SCREEN OR PERFORATION OPENINGS ARE: Continuous slot Mill slot Gauze wrapped Torch cut Drilled holes None (open hole) Louvered shutter Key punched Wire wrapped X Saw cut Other (specify) SCREEN-PERFORATED INTERVALS: From 22 ft. to 32 ft., From ft. to ft., From ft. to ft. GRAVEL PACK INTERVALS: From 14 ft. to 32 ft., From ft. to ft., From ft. to ft.

6 GROUT MATERIAL: Neat cement Cement grout X Bentonite Other Grout Intervals: From 1 ft. to 14 ft., From ft. to ft., From ft. to ft. What is the nearest source of possible contamination: Septic tank Lateral lines Pit privy Livestock pens Insecticide storage Other (specify below) Sewer lines Cesspool Sewage lagoon Fuel storage Abandoned water well X Watertight sewer lines Seepage pit Feedyard Fertilizer storage Oil well/gas well Direction from well 20 Distance from well 20

Table with columns: FROM, TO, LITHOLOGIC LOG, FROM, TO, LITHO. LOG (cont.) or PLUGGING INTERVALS. Rows contain handwritten entries: 0-8 Black Top Soil, 8-10 Brown sandy clay, 10-15 Fine sand, 15-32 pea size gravel.

7 CONTRACTOR'S OR LANDOWNER'S CERTIFICATION: This water well was X constructed, reconstructed, or plugged under my jurisdiction and was completed on (mo/day/year) 10-14-16 and this record is true to the best of my knowledge and belief. Kansas Water Well Contractor's License No. 252 This Water Well Record was completed on (mo/day/year) 10-14-16 under the business name of W. Wilson Water by hand by (signature) W. Wilson

INSTRUCTIONS: Use typewriter or ball point pen. PLEASE PRESS FIRMLY and PRINT clearly. Please fill in blanks and check the correct answers. Send three copies (white, blue, pink) to Kansas Department of Health and Environment, Bureau of Water, Geology Section, 1000 SW Jackson St., Suite 420, Topeka, Kansas 66612-1367. Telephone 785-296-5524. Send one copy to WATER WELL OWNER and retain one for your records. Include fee of \$5.00 for each constructed well. Visit us at http://www.kdheks.gov/waterwell/index.html.