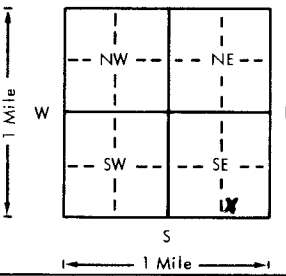
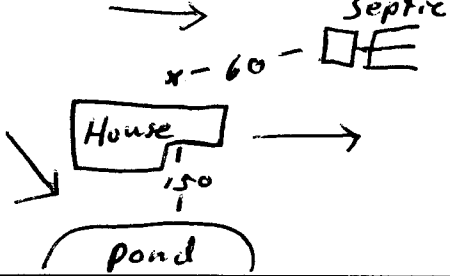


USE TYPEWRITER OR BALL
POINT PEN-PRESS FIRMLY,
PRINT CLEARLY.

WATER WELL RECORD
KSA 82a-1201-1215

Kansas Department of Health and
Environment-Division of Environment
(Water well Contractors)
Topeka, Kansas 66620

1. Location of well:	County Reno	Fraction SW 1/4 SE 1/4 SE 1/4	Section number 18	Township number T 22 S R 5	Range number 5
2. Distance and direction from nearest town or city: 3 mi N, 1/4 W		3. Owner of well: Wood Craft Builders			
Street address of well location if in city: of Hutchinson,		City, state, zip code: Hutchinson, KS 67501			
4. Locate with "X" in section below: 		Sketch map: 		6. Bore hole dia. 10 in. Completion date Well depth 76 ft. 7-19-79	
5. Type and color of material		From	To	7. <input checked="" type="checkbox"/> Cable tool <input checked="" type="checkbox"/> Rotary <input type="checkbox"/> Driven <input type="checkbox"/> Dug <input type="checkbox"/> Hollow rod <input type="checkbox"/> Jetted <input type="checkbox"/> Bored <input type="checkbox"/> Reverse rotary	
Fine Sand - Traces Brown Clay		0	37	8. Use: <input checked="" type="checkbox"/> Domestic <input type="checkbox"/> Public supply <input type="checkbox"/> Industry <input type="checkbox"/> Irrigation <input type="checkbox"/> Air conditioning <input type="checkbox"/> Stock <input type="checkbox"/> Lawn <input type="checkbox"/> Oil field water <input type="checkbox"/> Other	
Gray clay		37	46	9. Casing: Material PST Height: Above <input checked="" type="checkbox"/> below Threaded <input type="checkbox"/> Welded <input type="checkbox"/> Surface 48 in. RMP <input type="checkbox"/> PVC <input checked="" type="checkbox"/> Weight 3.58 lbs./ft. Dia. 6 in. to 76 ft. depth Wall Thickness: inches or Dia. <input type="checkbox"/> in. to <input type="checkbox"/> ft. depth Gauge No. 128	
Reddish Br Clay		46	56	10. Screens: Manufacturer's name Pumpco Type PVC Dia. 6 Slot gauge .03 Length 20 Set between 56 ft. and 76 ft. Gravel pack? Yes Size range of material F-1/2	
Fine sand - layers clay		56	77	11. Static water level: 11 ft. below land surface Date 7-21-79	
Brown Clay		77	79	12. Pumping level below land surfaces: 18 ft. after 2 hrs. pumping 15 g.p.m. ft. after <input type="checkbox"/> hrs. pumping <input type="checkbox"/> g.p.m. Estimated maximum yield 30 g.p.m.	
				13. Water sample submitted: <input checked="" type="checkbox"/> Yes <input type="checkbox"/> No Date	
				14. Well head completion: <input type="checkbox"/> Pitless adapter 48 Inches above grade	
				15. Well grouted? Yes With: <input checked="" type="checkbox"/> Neat cement <input type="checkbox"/> Bentonite <input type="checkbox"/> Concrete Depth: From 0 ft. to 10 ft.	
				16. Nearest source of possible contamination: ft. 60 Direction E Type Well disinfected upon completion? <input checked="" type="checkbox"/> Yes <input type="checkbox"/> No	
				17. Pump: <input checked="" type="checkbox"/> Not installed Manufacturer's name Model number <input type="checkbox"/> HP <input type="checkbox"/> Valts Length of drop pipe <input type="checkbox"/> ft. capacity <input type="checkbox"/> g.p.m. Type: <input type="checkbox"/> Submersible <input type="checkbox"/> Turbine <input type="checkbox"/> Jet <input type="checkbox"/> Reciprocating <input type="checkbox"/> Centrifugal <input type="checkbox"/> Other	
18. Elevation:		19. Remarks:		20. Water well contractor's certification: This well was drilled under my jurisdiction and this report is true to the best of my knowledge and belief. Miller Water Well 382 Business name Hutch, KS License No. Address Egan Miller Date 7-21-79 Signed Egan Miller Authorized representative	

Forward the white, blue and pink copies to the Department of Health and Environment

Form WWC-5