

USE TYPEWRITER OR BALL POINT PEN-PRESS FIRMLY, PRINT CLEARLY.


WATER WELL RECORD
KSA 82a-1201-1215

Kansas Department of Health and Environment-Division of Environment
(Water well Contractors)
Topeka, Kansas 66620

1. Location of well: County **Reno** Fraction **NE 1/4 NE 1/4 SW 1/4** Section number **18** Township number **T 22 S** Range number **R 5 E** EW

2. Distance and direction from nearest town or city: **3 N 1/2 E 1/2 N 30th & Plum**
Street address of well location if in city: **Hutchinson Kan**

3. Owner of well: **Gary Rohrer**
R.R. or street: **RR 3**
City, state, zip code: **Hutchinson Kan 67501**

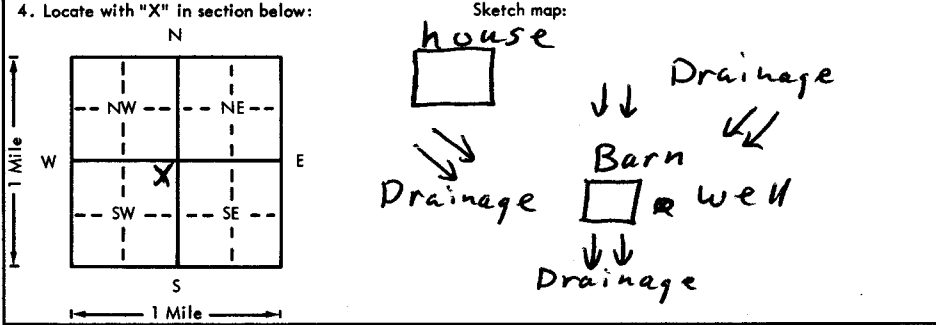

6. Bore hole dia. 12 in. Completion date 12-14-77
Well depth 77 ft.

7. Cable tool Rotary Driven Dug
 Hollow rod Jetted Bored Reverse rotary

8. Use: Domestic Public supply Industry
 Garden Irrigation Air conditioning Stock
 Lawn Oil field water Other

9. Casing: Material Plas Height: above or below
Threaded Welded Glue Surface 12 in.
RMP PVC Weight lbs./ft.
Dia. 6 in. to 77 ft. depth Wall Thickness: inches or
Dia. in. to ft. depth gage No. 1175

5. Type and color of material

	From	To
fine sand	0	16
sandy brown clay	16	22
fine sand	22	30
brown & grey clay	30	35
sandy clay	35	45
brown & grey clay	45	58
fine sand	58	77

10. Screen: Manufacturer's name J&L
Type RMP Dia. 6"
Slot/gauze 1/8 hole Length 25'
Set between 52 ft. and 77 ft.
 ft. and ft.
Gravel pack? yes Size range of material 1/8-1/2"

11. Static water level: 15 ft. below land surface mo./day/yr. Date 12-14-77

12. Pumping level below land surfaces:
24 ft. after 1 hrs. pumping 15 g.p.m.
 ft. after hrs. pumping g.p.m.
Estimated maximum yield 20 g.p.m.

13. Water sample submitted: mo./day/yr.
Yes No Date

14. Well head completion:
 Pitless adapter 12 Inches above grade

15. Well grouted? yes
With: Neat cement Bentonite Concrete
Depth: From 3 ft. to 13 ft.

16. Nearest source of possible contamination:
ft. 300 Direction NW Type Septic
Well disinfected upon completion? Yes No

17. Pump: Not installed
Manufacturer's name
Model number HP Volts
Length of drop pipe ft. capacity g.p.m.
Type:
 Submersible Turbine
 Jet Reciprocating
 Centrifugal Other

18. Elevation: _____

19. Remarks:
This barn does not have any corrals or livestock. So nearest contamination is from house.

Topography:
 Hill
 Slope
 Upland
 Valley

20. Water well contractor's certification:
This well was drilled under my jurisdiction and this report is true to the best of my knowledge and belief.
Price Water Well 193
Business name Price Water Well License No.
Address RR 3 Hutchinson
Signed John Davenport Date 5-23-77
Authorized representative

22
-5
50
L
8
NE
NE
SW
1/4
1/4
1/4