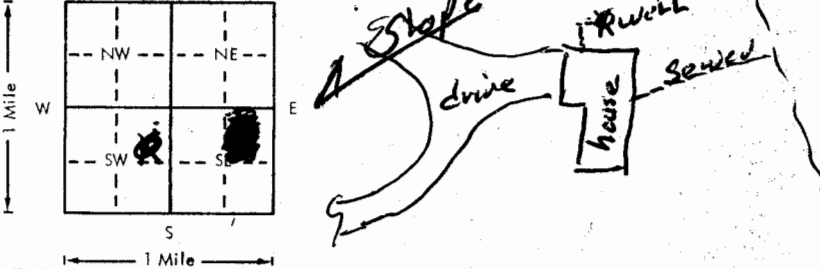


USE TYPEWRITER OR BALL
POINT PEN-PRESS FIRMLY,
PRINT CLEARLY.

WATER WELL RECORD
KSA 82a-1201-1215

Kansas Department of Health and
Environment-Division of Environment
(Water well Contractors)
Topeka, Kansas 66620

topeka

1. Location of well:	County RENO	Fraction SE 1/4 NE 1/4 SW 1/4	Section number 34	Township number 14N 23S	Range number 5
2. Distance and direction from nearest town or city: 1 - EAST of Hutch on 30th Street			3. Owner of well: Ken Krusemark R.R. or street: 517 N MAIN City, state, zip code: HESSTON, KNS		
4. Locate with "X" in section below: PRairie Hills ADD.			6. Bore hole dia. 10 in. Completion date 8-26-77 Well depth 93 ft.		
			7. ☒ Cable tool ☒ Rotary ☐ Driven ☐ Dug ☐ Hollow rod ☐ Jetted ☐ Bored ☐ Reverse rotary		
			8. Use: ☒ Domestic ☐ Public supply ☐ Industry ☐ Irrigation ☐ Air conditioning ☐ Stock ☐ Lawn ☐ Oil field water ☐ Other		
5. Type and color of material			9. Casings: Material plastic Height Above or below Threaded ☐ Welded ☒ Surface 12 in. RMP 3" PVC ☒ Weight 18 lbs./ft. Dia. 3 in. to 93 ft. depth Wall Thickness: inches or Dia. 3 in. to 93 ft. depth gage No. 258		
			10. Screen: Manufacturer's name Western Plastic Type PVC Dia. 5" Slot/gauze #20 Length 18' x 10' Set between 50' ft. and 50' ft. 62' ft. and 92' ft. Gravel pack? ☒ Size range of material 48-14		
			11. Static water level: 23 ft. below land surface Date 8-26-77		
			12. Pumping level below land surfaces: ft. after 3 hrs. pumping 18 g.p.m. 35 ft. after 3 hrs. pumping 18 g.p.m. Estimated maximum yield 75 g.p.m.		
			13. Water sample submitted: Yes Date 8-26-77		
			14. Well head completion: ☒ Pitless adapter ☐ Inches above grade		
			15. Well grouted? ☒ With: ☒ Neat cement ☐ Bentonite ☐ Concrete Depth: From 10 ft. to 0 ft.		
			16. Nearest source of possible contamination: ft. NE Direction 34' Type sewer Well disinfected upon completion? ☒ Yes ☐ No		
			17. Pump: Manufacturer's name VALLEY Not installed Model number S-1807 HP 1/2 Volts 230 Length of drop pipe 65 ft. capacity 18 g.p.m. Type: ☒ Submersible ☐ Turbine ☐ Jet ☐ Reciprocating ☐ Centrifugal ☐ Other		
18. Elevation:			19. Remarks:		
Topography: ☒ Hill ☒ Slope ☐ Upland ☐ Valley			20. Water well contractor's certification: This well was drilled under my jurisdiction and this report is true to the best of my knowledge and belief. PAUL'S INC #125 Business name License No. Address HESSTON, KNS Signed Paul Bullard Date 8/30/77 Authorized representative		

Forward the white, blue and pink copies to the Department of Health and Environment

Form WWC-5