

County: Reno Fraction: NW NE SW Sec. 31 T. 22 S R. 5 W

**CORRECTION(S) to WATER WELL COMPLETION RECORD Form WWC-5** (to rectify lacking or incorrect information)

Owner: Brody Scott

If location corrected, was listed as:

Section-Township-Range: \_\_\_\_\_

Fraction (¼ calls): SE SE SE NW

Location changed to:

\_\_\_\_\_

NW NE SW

Other changes: Initial statements: \_\_\_\_\_

Changed to: \_\_\_\_\_

Comments: \_\_\_\_\_

Verification method: Confirmed well location with WW Contractor and used STR Finder.

Initials: JM Date: 8/10/21

Submitted by:  Kansas Geological Survey, Data Resources Library, 1930 Constant Ave., Lawrence, KS 66047-3724  
 Kansas Dept. of Health & Environment, Bureau of Water, 1000 SW Jackson, Suite 420, Topeka, KS 66612-1367

**WATER WELL RECORD Form WWC-5**


Original Record  Correction  Change in Well Use

Division of Water Resources App. No.  

Well ID  

**1 LOCATION OF WATER WELL:** County: Reno Fraction: SE 1/4 SE 1/4 SE 1/4 NW Section Number: 31 Township Number: R22 S Range Number: R25 E  W

**2 WELL OWNER:** Last Name: Scott First: Bradley Street or Rural Address where well is located (if unknown, distance and direction from nearest town or intersection): If at owner's address, check here:  plc  
 Business: 707 Idlewild Dr  
 Address:  
 Address:  
 City: Hutchinson State: Ks ZIP: 67502

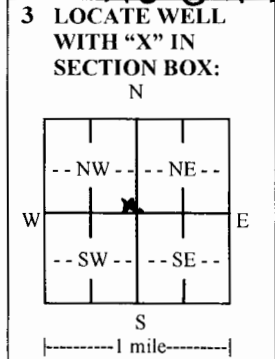

**4 DEPTH OF COMPLETED WELL:** 32 ft.  
 Depth(s) Groundwater Encountered: 1) 14 ft.  
 2) ..... ft. 3) ..... ft., or 4)  Dry Well  
 WELL'S STATIC WATER LEVEL: 14 ft.  
 below land surface, measured on (mo-day-yr) 6-17-21  
 above land surface, measured on (mo-day-yr) .....  
 Pump test data: Well water was ..... ft.  
 after 1/2 hours pumping ..... gpm  
 Well water was ..... ft.  
 after ..... hours pumping ..... gpm  
 Estimated Yield: ..... gpm  
 Bore Hole Diameter: 9 in. to 13.5 ft. and  
 ..... in. to ..... ft.

**5 Latitude:** ..... (decimal degrees)  
**Longitude:** ..... (decimal degrees)  
 Horizontal Datum:  WGS 84  NAD 83  NAD 27  
 Source for Latitude/Longitude:  
 GPS (unit make/model: .....)  
 (WAAS enabled?  Yes  No)  
 Land Survey  Topographic Map  
 Online Mapper: .....  
**6 Elevation:** ..... ft.  Ground Level  TOC  
 Source:  Land Survey  GPS  Topographic Map  
 Other .....

**7 WELL WATER TO BE USED AS:**

1. Domestic:  
 Household  
 Lawn & Garden  
 Livestock  
 Irrigation  
 Feedlot  
 Industrial

2.  Public Water Supply: well ID .....

3.  Dewatering: how many wells? .....

4.  Aquifer Recharge: well ID .....

5.  Monitoring: well ID .....

6.  Environmental Remediation: well ID .....

7.  Air Sparge  Soil Vapor Extraction

8.  Recovery  Injection

9.  Oil Field Water Supply: lease .....

10.  Test Hole: well ID .....

11.  Cased  Uncased  Geotechnical

12.  Geothermal: how many bores? .....

a)  Closed Loop  Horizontal  Vertical

b)  Open Loop  Surface Discharge  Inj. of Water

13.  Other (specify): .....

**Was a chemical/bacteriological sample submitted to KDHE?**  Yes  No If yes, date sample was submitted: .....

Water well disinfected?  Yes  No

**8 TYPE OF CASING USED:**  Steel  PVC  Other ..... CASING JOINTS:  Glued  Clamped  Welded  Threaded  
 Casing diameter ..... 5 in. to ..... 32 ft., Diameter ..... in. to ..... ft., Diameter ..... in. to ..... ft.  
 Casing height above land surface ..... 132 in. Weight 229 lbs./ft. Wall thickness or gauge No. 160  
 TYPE OF SCREEN OR PERFORATION MATERIAL:  
 Steel  Stainless Steel  Fiberglass  PVC  Other (Specify) .....  
 Brass  Galvanized Steel  Concrete tile  None used (open hole)  
 SCREEN OR PERFORATION OPENINGS ARE:  
 Continuous Slot  Mill Slot  Gauze Wrapped  Torch Cut  Drilled Holes  Other (Specify) .....  
 Louvered Shutter  Key Punched  Wire Wrapped  Saw Cut  None (Open Hole)  
 SCREEN-PERFORATED INTERVALS: From 22 ft. to 32 ft., From ..... ft. to ..... ft., From ..... ft. to ..... ft.  
 GRAVEL PACK INTERVALS: From 13.5 ft. to 32 ft., From ..... ft. to ..... ft., From ..... ft. to ..... ft.

**9 GROUT MATERIAL:**  Neat cement  Cement grout  Bentonite  Other .....

Grout Intervals: From 1 ft. to 13.5 ft., From ..... ft. to ..... ft., From ..... ft. to ..... ft.

**Nearest source of possible contamination:**

Septic Tank  Lateral Lines  Pit Privy  Livestock Pens  Insecticide Storage

Sewer Lines  Cess Pool  Sewage Lagoon  Fuel Storage  Abandoned Water Well

Watertight Sewer Lines  Seepage Pit  Feedyard  Fertilizer Storage  Oil Well/Gas Well

Other (Specify) .....

Direction from well? SW Distance from well? 22'

10 FROM	TO	LITHOLOGIC LOG	FROM	TO	LITHO. LOG (cont.) or PLUGGING INTERVALS
0	4	Black Top soil			
4	8	Black sandy soil			
8	14	Fine sand			
14	32	1/2 size gravel			
Notes:					

**11 CONTRACTOR'S OR LANDOWNER'S CERTIFICATION:** This water well was  constructed,  reconstructed, or  plugged under my jurisdiction and was completed on (mo-day-year) 6-17-21, and this record is true to the best of my knowledge and belief. Kansas Water Well Contractor's License No. 250. This Water Well Record was completed on (mo-day-year) 6-17-21 under the business name of W. 160 Water Systems. Signature: [Signature]