

CORRECTION(S) TO WATER WELL RECORD (WWC-5)
(to rectify lacking or incorrect information)

County: Reno

Location listed as:

Location ~~changed to:~~

Section-Township-Range: _____

21-225-6W

Fraction ($\frac{1}{4}$ $\frac{1}{4}$ $\frac{1}{4}$): _____

C NW

Other changes: Initial statements: DWR Application Number: 42,169

Changed to: 42,165

Comments: _____

verification method: Water rights records in WIMAS database, and mapping tool & aerial photos on KGS website.

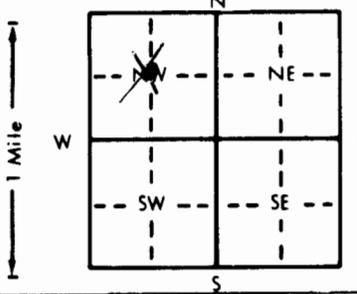
initials: DRK date: 5/5/2010

submitted by: Kansas Geological Survey, Data Resources Library, 1930 Constant Ave., Lawrence, KS 66047-3726
to: Kansas Dept of Health & Environment, Bureau of Water, 1000 SW Jackson, Suite 420, Topeka, KS 66612-1367.

1 LOCATION OF WATER WELL: Fraction near 1/4 center 1/4 NW 1/4 Section Number 21 Township Number T 22 S Range Number R 6 **NEW**

Distance and direction from nearest town or city street address of well if located within city?
 3 miles west of Hutchinson

2 WATER WELL OWNER: Dave Stroberg
 RR#, St. Address, Box # : RR 3 Board of Agriculture, Division of Water Resources
 City, State, ZIP Code : Hutchinson, KS 67501 Application Number: 42,169

3 LOCATE WELL'S LOCATION WITH AN "X" IN SECTION BOX:


4 DEPTH OF COMPLETED WELL . . . 63 ft. ELEVATION:
 Depth(s) Groundwater Encountered 1. 11 ft. 2. ft. 3. ft.
 WELL'S STATIC WATER LEVEL . . . 11 ft. below land surface measured on mo/day/yr . . . 1/16/97
 Pump test data: Well water was ft. after hours pumping gpm
 Est. Yield . 1000 . . . gpm: Well water was ft. after hours pumping gpm
 Bore Hole Diameter. . . 30 in. to . . . 63 ft., and in. to ft.
 WELL WATER TO BE USED AS: 5 Public water supply 8 Air conditioning 11 Injection well
 1 Domestic 3 Feedlot 6 Oil field water supply 9 Dewatering 12 Other (Specify below)
 Irrigation 4 Industrial 7 Lawn and garden only 10 Monitoring well
 Was a chemical/bacteriological sample submitted to Department? Yes No X; If yes, mo/day/yr sample was submitted
 Water Well Disinfected? Yes X No

5 TYPE OF BLANK CASING USED: 5 Wrought iron 8 Concrete tile CASING JOINTS: Glued Clamped
 1 Steel 3 RMP (SR) 6 Asbestos-Cement 9 Other (specify below) Welded
 PVC 4 ABS 7 Fiberglass Threaded
 Blank casing diameter . . . 16 in. to . . . 23 ft., Dia in. to ft., Dia in. to ft.
 Casing height above land surface . . . 12 in., weight . . . 16.15 lbs./ft. Wall thickness or gauge No. . . . 500
 TYPE OF SCREEN OR PERFORATION MATERIAL: PVC 10 Asbestos-cement
 1 Steel 3 Stainless steel 5 Fiberglass 8 RMP (SR) 11 Other (specify)
 2 Brass 4 Galvanized steel 6 Concrete tile 9 ABS 12 None used (open hole)
 SCREEN OR PERFORATION OPENINGS ARE: 5 Gauzed wrapped 8 Saw cut 11 None (open hole)
 1 Continuous slot Mill slot 6 Wire wrapped 9 Drilled holes
 2 Louvered shutter 4 Key punched 7 Torch cut 10 Other (specify)
 SCREEN-PERFORATED INTERVALS: From 23 ft. to . . . 63 ft., From ft. to ft.
 From ft. to ft., From ft. to ft.
 GRAVEL PACK INTERVALS: From 20 ft. to . . . 63 ft., From ft. to ft.
 From ft. to ft., From ft. to ft.

6 GROUT MATERIAL: 1 Neat cement Cement grout 3 Bentonite 4 Other
 Grout Intervals: From . . . 0 ft. to . . . 20 ft., From ft. to ft., From ft. to ft.
 What is the nearest source of possible contamination: none within 1/4 mile 10 Livestock pens 14 Abandoned water well
 1 Septic tank 4 Lateral lines 7 Pit privy 11 Fuel storage 15 Oil well/Gas well
 2 Sewer lines 5 Cess pool 8 Sewage lagoon 12 Fertilizer storage 16 Other (specify below)
 3 Watertight sewer lines 6 Seepage pit 9 Feedyard 13 Insecticide storage

Direction from well? How many feet?

FROM	TO	LITHOLOGIC LOG	FROM	TO	PLUGGING INTERVALS
0	3	Topsoil			
3	15	Fine to Medium Sand			
15	62	Medium to coarse sand			
62	63	clay mixed with a little sand			

7 CONTRACTOR'S OR LANDOWNER'S CERTIFICATION: This water well was (1) constructed, (2) reconstructed, or (3) plugged under my jurisdiction and was completed on (mo/day/year) 1/16/97 and this record is true to the best of my knowledge and belief. Kansas Water Well Contractor's License No. . . . 138 This Water Well Record was completed on (mo/day/yr) 1/23/97 under the business name of Peterson Irrigation, Inc. by (signature) Mike Peters

INSTRUCTIONS: Use typewriter or ball point pen. PLEASE PRESS FIRMLY and PRINT clearly. Please fill in blanks, underline or circle the correct answers. Send top three copies to Kansas Department of Health and Environment, Bureau of Water, Topeka, Kansas 66620-0001. Telephone: 913-296-5545. Send one to WATER WELL OWNER and retain one for your records.

OFFICE USE ONLY
T
R
EAW
SEC.
1/4
1/4
1/4