

Phone 24

ANDERSEN & DARLING
JAMESTOWN, KANSAS

1-228-6W ⑪
SE

March 28

—Log Of Test Well—

Date of Test April 11


Customer Dr. Blank

Address Hutchinson

Location 6 miles n. on Plum St.

Static Water Level 5 ft.

2

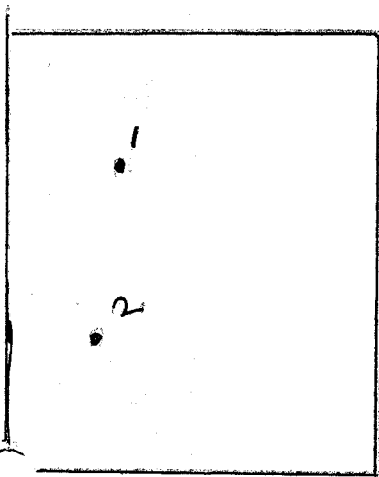

2	Soil	2
6	Fine sand	4
10	Clay, Sand Mixed	4
12	Fine sand	2
16	Clay Sand Mixed	4
24	Fine sand	8
40	Brown Clay	16
46	clay, sand mixed	6
48	Sand	2
50	sand clay	2
53	Rocky Formation	3
64	sandy clay	11
	Brown Clay	
	Hard Formation	36 ft.
100		