

1	LOCATION OF WATER WELL:	Fraction	Section Number	Township Number	Range Number
County:	<i>Reno</i>	<i>SW</i> $\frac{1}{4}$ <i>SW</i> $\frac{1}{4}$ <i>NE</i> $\frac{1}{4}$	<i>15</i>	T <i>22</i> S	R <i>6</i> E/W

Distance and direction from nearest town or city street address of well if located within city?


2 WATER WELL OWNER: Mike Nevius

RR#, St. Address, Box # : 1915 W. 82nd
City, State, ZIP Code : Hutchinson, Ks 67501

Board of Agriculture, Division of Water Resources
Application Number:

3 LOCATE WELL'S LOCATION WITH 4 DEPTH OF COMPLETED WELL 45 ft. ELEVATION:

AN "X" IN SECTION BOX:

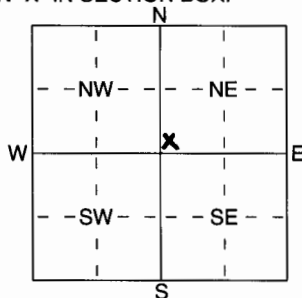

Depth(s) Groundwater Encountered	1	ft 2	ft 3	ft
----------------------------------	---	------	------	----

Depth(s) Groundwater Encountered 1 ft. 2 ft. 3 ft.
WELL'S STATIC WATER LEVEL 32 ft. below land surface measured on mo/day/yr 3-6-07

Pump test data:	Well water was	ft. after	hours pumping	gpm	
Est. Yield	gpm:	Well water was	ft. after	hours pumping	gpm

WELL WATER TO BE USED AS:

1 Domestic	3 Feedlot	5 Public water supply	8 Air conditioning	11 Injection well
2 Irrigation	4 Industrial	6 Oil field water supply	9 Dewatering	12 Other (Specify below)
		7 Domestic (lawn & garden)	10 Monitoring well	

Was a chemical/bacteriological sample submitted to Department? Yes No **X**; If yes, mo/day/yrs sample was submitted
Water Well Disinfected? Yes **X** No

5	TYPE OF BLANK CASING USED:
---	----------------------------

5 Wrought iron

8 Concrete tile

CASING JOINTS: Glued Clamped

1 Steel	3 RMP (SR)
2 PVC	4 ABS

6 Asbestos-Cement
7 Fiberglass

9 Other (specify below)

Welded

Threaded

Blank casing diameter 5 in. to 33 ft. Dia in. to ft. Dia in. to ft.

Casing height above land surface 20 in., weight 160 # lbs./ft. Wall thickness or gauge No. 214

TYPE OF SCREEN OR PERFORATION MATERIAL:

1 Steel 3 Stainless Steel 5 Fiberglass 8 RMP (SR) 11 Other (Specify)

2 Brass 4 Galvanized Steel 6 Concrete tile 9 ABS 12 None used (open hole)

SCREEN OR PERFORATION OPENINGS ARE:

1 Continuous slot 3 Mill slot 6 Wire wrapped 9 Drilled holes
2 Louvered shutter 4 Key punched 7 Torch cut 10 Other (specify) ft.

SCREEN-PERFORATED INTERVALS: From 33 ft. to 45 ft. From _____ ft. to _____ ft.

GRAVEL PACK INTERVALS: From 45 ft. to 20 ft. From _____ ft. to _____ ft.
From _____ ft. to _____ ft. From _____ ft. to _____ ft.

6	GROUT MATERIAL:	1 Neat cement	2 Cement grout	3 Bentonite	4 Other <i>Hole Plug</i>
---	-----------------	---------------	----------------	-------------	--------------------------

Grout Intervals: From 0 ft. to 20 ft., From _____ ft. to _____ ft., From _____ ft. to _____ ft.

What is the nearest source of possible contamination:

1 Septic tank	4 Lateral lines	7 Pit privy	11 Fuel storage	15 Oil well/Gas well
2 Sewer lines	5 Cess pool	8 Sewage lagoon	12 Fertilizer storage	16 <u>Other</u> (specify below)
3 Watertight sewer lines	6 Seepage pit	9 Feedyard	13 Insecticide storage	<u>None</u>

Direction from well?

How many feet?

[illegible]

7 CONTRACTOR'S OR LANDOWNER'S CERTIFICATION: This water well was (1) constructed, (2) reconstructed, or (3) plugged under my jurisdiction and was completed on (mo/day/year) 3-6-07 and this record is true to the best of my knowledge and belief. Kansas Water Well Contractor's Licence No. 134 This Water Well Record was completed on (mo/day/yr) 3-16-07 under the business name of Basement to Basement, Inc. by (signature) James Dodson