

WATER WELL PLUGGING RECORD

Form WWC-5P

KSA 82a-1212

ID NO.

1 LOCATION OF WATER WELL: County: RENO	Fraction SE ¼ NW ¼ SW ¼ ¼	Section Number 2	Township Number T 22 S	Range Number 6 <input type="checkbox"/> E <input checked="" type="checkbox"/> W
---	------------------------------	----------------------------	----------------------------------	--

Street/Rural Address of Well Location; if unknown, distance & direction from nearest town or intersection: If at owner's address, check here ☐ CONSTRUCTED 4 @ 300'

Global Positioning Systems (GPS) information:

Latitude: **38.164156** (in decimal degrees)

Longitude: **-97.953828** (in decimal degrees)

Elevation:

Datum: ☐ WGS84, ☐ NAD83, ☐ NAD27

Collection Method:


☒ GPS unit (Make/Model: **MAGELLEN**)

☐ Digital Map/Photo, ☐ Topographic Map, ☐ Land Survey

Est. Accuracy: ☐ < 3 m, ☐ 3-5 m, ☐ 5-15 m, ☐ > 15 m

2 WATER WELL OWNER: **SCOTT COOLEY**
RR#, St. Address, Box #: **10071 PAGANICA PASS**
City, State ZIP Code: **HUTCHINSON, KS 67502**

3 MARK WELL'S LOCATION WITH AN "X" IN SECTION BOX:

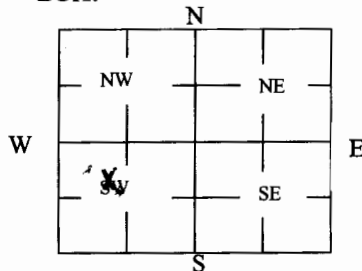

4 DEPTH OF WELL **300** ft.

WELL'S STATIC WATER LEVEL **NA** ft

WELL WAS USED AS:

☐ Domestic
☐ Irrigation
☐ Feedlot
☐ Industrial

☐ Public Water Supply
☐ Oil Field Water Supply
☐ Domestic (Lawn & Garden)
☐ Air Conditioning

☐ Dewatering
☐ Monitoring
☐ Injection Well
☒ Other **Geothermal**

Was a chemical/bacteriological sample submitted to Department? Yes ☐ No ☐

5 TYPE OF BLANK CASING USED:

☐ Steel
☐ PVC

☐ RMP (SR)
☐ ABS

☐ Wrought
☐ Asbestos-Cement

☐ Fiberglass
☐ Concrete Tile

☒ Other (Specify below)
NA

Blank casing diameter _____ in. Was casing pulled? Yes ☐ No ☐ If yes, how much _____
Casing height above or below land surface _____ in.

6 GROUT PLUG MATERIAL: ☐ Neat cement ☐ Cement grout ☒ Bentonite ☐ Other _____

Grout Plug Intervals: From **0** ft. to **300** ft., From _____ ft. to _____ ft., From _____ to _____ ft.

What is the nearest source of possible contamination:

☐ Septic tank
☐ Sewer lines
☐ Watertight sewer lines
☐ Lateral lines
☐ Cess pool

☐ Seepage pit
☐ Pit privy
☐ Sewage lagoon
☐ Feedyard
☐ Livestock pens

☐ Fuel Storage
☐ Fertilizer storage
☐ Insecticide storage
☐ Abandoned water well
☐ Oil well/Gas well

☒ Other (specify below)
HOUSE

Direction from well? **EAST**

How many feet? **15**

FROM	TO	PLUGGING MATERIALS	FROM	TO	PLUGGING MATERIALS
0	30	BROWN SAND			
30	60	MIXED BROWN CLAY & SAND			
60	100	SAND			
100	140	GRAY CLAY MIXED WITH SAND			
140	160	GRAY CLAY			
160	300	GRAY CLAY MIXED WITH RED CLAY			

7 CONTRACTOR'S OR LANDOWNER'S CERTIFICATION: This water well was plugged under my jurisdiction and was completed on (mo/day/year) **9/24/12** and this record is true to the best of my knowledge and belief. Kansas Water Well Contractor's License No. **812**. This Water Well Record was completed on (mo/day/year) **10/3/12** under the business name of **Environmental Loop Service, Inc** by (signature) **Richard Moore**

INSTRUCTIONS: Use typewriter or ballpoint pen. Please press firmly and print clearly. Please fill in blanks, underline or circle the correct answers. Send top three copies to Kansas Department of Health and Environment, Bureau of Water, Geology Section, 1000 SW Jackson St., Ste. 420, Topeka, Kansas 66612-1367. Telephone: 785/296-5524. Send one to Water Well Owner and retain one for your records. Visit us at <http://www.kdheks.gov/waterwell/index.html>.

Check one: ☒ White Copy ☐ Blue Copy ☐ Pink Copy