

WATER WELL RECORD


Form WWC-5

Division of Water Resources App. No. _____

LOCATION OF WATER WELL: Fraction SE 1/4 NW 1/4 SW 1/4
 County: Reno
 Street/Rural Address of Well Location; if unknown, distance & direction from nearest town or intersection: If at owner's address, check here

Section Number 36 Township No. T 22 S Range Number R 6 E W
Global Positioning System (GPS) information:
 Latitude: _____ (in decimal degrees)
 Longitude: _____ (in decimal degrees)
 Elevation: _____
 Datum: WGS 84, NAD 83, NAD 27
 Collection Method:
 GPS unit (Make/Model: _____)
 Digital Map/Photo, Topographic Map, Land Survey
 Est. Accuracy: <3 m, 3-5 m, 5-15 m, >15 m

WATER WELL OWNER: Janet Hallman
 RR#, Street Address, Box #: 110 Downing Rd
 City, State, ZIP Code: Hutchinson, KS 67502

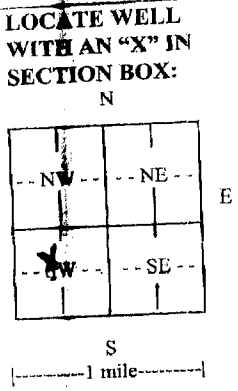

4 DEPTH OF COMPLETED WELL 33 ft.
 Depth(s) Groundwater Encountered (1) ft. (2) ft. (3) ft.
WELL'S STATIC WATER LEVEL 17 ft. below land surface measured on mo/day/yr 4-10-15
 Pump test data: Well water was ft. after 112 hours pumping 250-15 gpm
 EST. YIELD gpm Well water was ft. after hours pumping gpm
 Bore Hole Diameter 9 in. to 17 ft., and in. to ft.
WELL WATER TO BE USED AS: Public water supply Geothermal Injection well
 Domestic Feedlot Oil field water supply Dewatering Other (Specify below)
 Irrigation Industrial Domestic-lawn & garden Monitoring well
 Was a chemical/bacteriological sample submitted to Department? Yes No
 If yes, mo/day/yr sample was submitted.....
 Water well disinfected? Yes No

5 TYPE OF CASING USED: Steel PVC Other
CASING JOINTS: Gilted Clamped Welded Threaded
 Casing diameter 5 in. to 33 ft., Diameter in. to ft., Diameter in. to ft.
 Casing height above land surface 12 in., Weight 2.29 lbs./ft., Wall thickness or gauge No. 160

TYPE OF SCREEN OR PERFORATION MATERIAL: Steel Stainless Steel PVC Other (Specify)
 Brass Galvanized Steel None used (open hole)
SCREEN OR PERFORATION OPENINGS ARE: Continuous slot Mill slot Gauze wrapped Torch cut Drilled holes None (open hole)
 Louvered shutter Key punched Wire wrapped Saw cut Other (specify)
SCREEN-PERFORATED INTERVALS: From 23 ft. to 33 ft., From ft. to ft.
GRAVEL PACK INTERVALS: From 17 ft. to 33 ft., From ft. to ft.

6 GROUT MATERIAL: Neat cement Cement grout Bentonite Other
 Grout Intervals: From ft. to ft., From ft. to ft., From ft. to ft.
 What is the nearest source of possible contamination:
 Septic tank Lateral lines Pit privy Livestock pens Insecticide storage Other (specify below)
 Sewer lines Cesspool Sewage lagoon Fuel storage Abandoned water well
 Watertight sewer lines Seepage pit Feedyard Fertilizer storage Oil well/gas well
 Direction from well west Distance from well 40'

FROM	TO	LITHOLOGIC LOG	FROM	TO	LITHO. LOG (cont.) or PLUGGING INTERVALS
0	10	Black top soil			
10	12	Sandy top soil			
12	17	fine sand			
17	33	sand & pea size gravel			

7 CONTRACTOR'S OR LANDOWNER'S CERTIFICATION: This water well was constructed, reconstructed, or plugged under my jurisdiction and was completed on (mo/day/year) 4-10-15 and this record is true to the best of my knowledge and belief.
 Kansas Water Well Contractor's License No. 750 This Water Well Record was completed on (mo/day/year) 4-10-15
 under the business name of Wilson Water Systems by (signature) Jim Wilson

INSTRUCTIONS: Use typewriter or ball point pen. PLEASE PRESS FIRMLY and PRINT clearly. Please fill in blanks and check the correct answers. Send three copies (white, blue, pink) to Kansas Department of Health and Environment, Bureau of Water, Geology Section, 1000 SW Jackson St., Suite 420, Topeka, Kansas 66612-1367. Telephone 785-296-5524. Send one copy to WATER WELL OWNER and retain one for your records. Include fee of \$5.00 for each constructed well. Visit us at <http://www.kdheks.gov/waterwell/index.html>.