
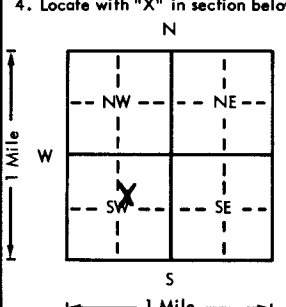
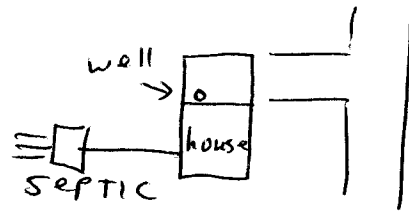


USE TYPEWRITER OR BALL POINT PEN-PRESS FIRMLY, PRINT CLEARLY.

WATER WELL RECORD  
KSA 82a-1201-1215

Kansas Department of Health and Environment-Division of Environment (Water well Contractors)  
Topeka, Kansas 66620

1. Location of well: <input checked="" type="checkbox"/>	County <u>Reno</u>	Fraction <u>SW 1/4 NE 1/4 SW 1/4</u>	Section number <u>22</u>	Township number <u>T 22 S R 6</u>	Range number <u>6</u>																					
2. Distance and direction from nearest town or city: <u>5901 Johnson Dr.</u> Street address of well location if in city:		3. Owner of well: <u>Jayhawk Realty Co.</u> R.R. or street: <u>510 E. 17th</u> City, state, zip code: <u>Hutchinson Kan 67501</u>																								
4. Locate with "X" in section below:		Sketch map:		6. Bore hole dia. <u>9</u> in. Completion date <u>3-31-75</u> Well depth <u>30</u> ft.																						
				7. Cable tool <input type="checkbox"/> Rotary <input type="checkbox"/> Driven <input checked="" type="checkbox"/> Aug <input type="checkbox"/> Hollow rod <input type="checkbox"/> Jetted <input checked="" type="checkbox"/> Bored <input type="checkbox"/> Reverse rotary																						
5. Type and color of material		<table border="1" style="width:100%; border-collapse: collapse;"> <thead> <tr> <th style="width:80%;"></th> <th style="width:10%;">From</th> <th style="width:10%;">To</th> </tr> </thead> <tbody> <tr> <td><u>Sandy top soil</u></td> <td><u>0</u></td> <td><u>3</u></td> </tr> <tr> <td><u>brown sandy clay</u></td> <td><u>3</u></td> <td><u>7</u></td> </tr> <tr> <td><u>brown &amp; grey clay</u></td> <td><u>7</u></td> <td><u>9</u></td> </tr> <tr> <td><u>brown sandy clay</u></td> <td><u>9</u></td> <td><u>11</u></td> </tr> <tr> <td><u>fine gravel</u></td> <td><u>11</u></td> <td><u>13</u></td> </tr> <tr> <td><u>medium gravel</u></td> <td><u>13</u></td> <td><u>30</u></td> </tr>Use: <input checked="" type="checkbox"/> Domestic <input type="checkbox"/> Public supply <input type="checkbox"/> Industry <input type="checkbox"/> Irrigation <input type="checkbox"/> Air conditioning <input type="checkbox"/> Stock <input type="checkbox"/> Lawn <input type="checkbox"/> Oil field water <input type="checkbox"/> Other	
				9. Casing: Material <u>Plas</u> Height: <u>Above</u> or below Threaded <input type="checkbox"/> Welded <u>Blue</u> Surface <u>12</u> in. RMP <input checked="" type="checkbox"/> PVC <input type="checkbox"/> Weight <u>        </u> lbs./ft. Dia. <u>6</u> in. to <u>30</u> ft. depth Wall Thickness: inches or Dia. <u>        </u> in. to <u>        </u> ft. depth gage No. <u>1175</u>																						
				10. Screen: Manufacturer's name <u>J&amp;L</u> Type <u>RMP</u> Dia. <u>6"</u> Slot/gauze <u>1/8 hole</u> Length <u>10'</u> Set between <u>20</u> ft. and <u>30</u> ft. ft. and <u>        </u> ft. Gravel pack? <u>NO</u> Size range of material <u>        </u>																						
				11. Static water level: <u>11</u> ft. below land surface Date <u>3-31-75</u> mo./day/yr.																						
				12. Pumping level below land surfaces: <u>11 1/2</u> ft. after <u>1</u> hrs. pumping <u>20</u> g.p.m. <u>        </u> ft. after <u>        </u> hrs. pumping <u>        </u> g.p.m. Estimated maximum yield <u>50</u> g.p.m.																						
				13. Water sample submitted: <u>        </u> mo./day/yr. Yes <input checked="" type="checkbox"/> No <input type="checkbox"/> Date <u>        </u>																						
				14. Well head completion: <input type="checkbox"/> Pitless adapter <u>12</u> inches above grade																						
				15. Well grouted? <u>yes</u> With: <input checked="" type="checkbox"/> Neat cement <input type="checkbox"/> Bentonite <input type="checkbox"/> Concrete Depth: From <u>3</u> ft. to <u>12</u> ft.																						
				16. Nearest source of possible contamination: ft. <u>70</u> Direction <u>SW</u> Type <u>Septic</u> Well disinfected upon completion? <input checked="" type="checkbox"/> Yes <input type="checkbox"/> No																						
				17. Pump: <input checked="" type="checkbox"/> Not installed Manufacturer's name <u>        </u> Model number <u>        </u> HP <u>        </u> Volts <u>        </u> Length of drop pipe <u>        </u> ft. capacity <u>        </u> g.p.m. Type: <input type="checkbox"/> Submersible <input type="checkbox"/> Turbine <input type="checkbox"/> Jet <input type="checkbox"/> Reciprocating <input type="checkbox"/> Centrifugal <input type="checkbox"/> Other																						
				18. Elevation:																						
				19. Remarks:																						
Topography: <input type="checkbox"/> Hill <input type="checkbox"/> Slope <input type="checkbox"/> Upland <input checked="" type="checkbox"/> Valley				20. Water well contractor's certification: This well was drilled under my jurisdiction and this report is true to the best of my knowledge and belief. <u>Price Water Well 193</u> Business name <u>RR3 Hutchinson</u> License No. <u>        </u> Address <u>        </u> Signed <u>John Damant</u> Date <u>8/10/75</u> Authorized representative																						

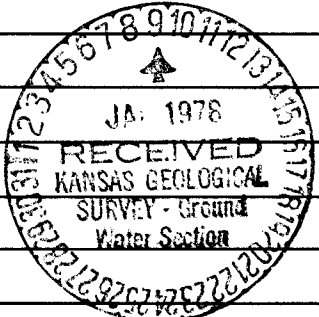

22  
 60  
 22  
 SW NE SW  
 1/4 1/4 1/4

Forward the white, blue and pink copies to the Department of Health and Environment

Form WWC-5