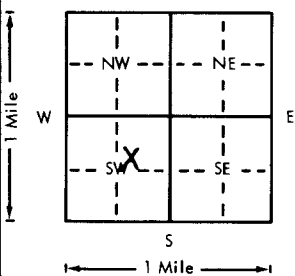
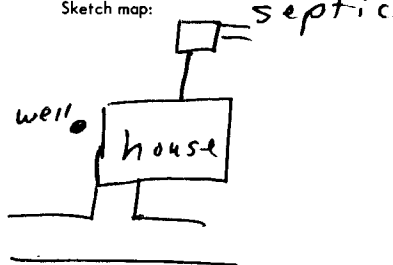


USE TYPEWRITER OR BALL
POINT PEN-PRESS FIRMLY,
PRINT CLEARLY.

WATER WELL RECORD
KSA 82a-1201-1215

Kansas Department of Health and
Environment-Division of Environment
(Water well Contractors)
Topeka, Kansas 66620

1. Location of well:		County Reno	Fraction SW 1/4 NE 1/4 SW 1/4	Section number 22	Township number T 22 S	Range number R 6 E
2. Distance and direction from nearest town or city: 2406 W. 59th Street address of well location if in city: Hutchinson			3. Owner of well: Charles Amrine R.R. or street: Box 473 City, state, zip code: Hutchinson Kan 67501			
4. Locate with "X" in section below:		Sketch map:		6. Bore hole dia. 9 in. Completion date 8-15-77 Well depth 30 ft.		
				7. <input type="checkbox"/> Cable tool <input type="checkbox"/> Rotary <input type="checkbox"/> Driven <input checked="" type="checkbox"/> Dug <input type="checkbox"/> Hollow rod <input type="checkbox"/> Jetted <input checked="" type="checkbox"/> Bored <input type="checkbox"/> Reverse rotary		
5. Type and color of material		From	To	8. Use: <input checked="" type="checkbox"/> Domestic <input type="checkbox"/> Public supply <input type="checkbox"/> Industry <input type="checkbox"/> Irrigation <input type="checkbox"/> Air conditioning <input type="checkbox"/> Stock <input type="checkbox"/> Lawn <input type="checkbox"/> Oil field water <input type="checkbox"/> Other		
brown sandy soil		0	2	9. Casing: Material Plas Height: 12 in. or below Threaded <input type="checkbox"/> Welded <input checked="" type="checkbox"/> Surface 12 in. RMP <input checked="" type="checkbox"/> PVC <input type="checkbox"/> Weight 15 lbs./ft. Dia. 6 in. to 30 ft. depth Wall Thickness: inches or Dia. 1/2 in. to 1/2 ft. depth gage No. 1175		
brown sandy clay		2	7	10. Screen: Manufacturer's name J&L Type RMP Dia. 6" Slot/gauze 1/8 hole Length 10' Set between 20 ft. and 30 ft. ft. and ft. Gravel pack? No Size range of material		
fine sand		7	9	11. Static water level: 11 ft. below land surface Date 8-15-77 mo./day/yr.		
fine gravel		9	13	12. Pumping level below land surfaces: 11 1/2 ft. after 1 hrs. pumping 15 g.p.m. ft. after hrs. pumping g.p.m. Estimated maximum yield 75 g.p.m.		
medium gravel		13	30	13. Water sample submitted: X Yes X No Date		
				14. Well head completion: <input type="checkbox"/> Pitless adapter 12 inches above grade		
				15. Well grouted? yes With: <input checked="" type="checkbox"/> Neat cement <input type="checkbox"/> Bentonite <input type="checkbox"/> Concrete Depth: From 3 ft. to 13 ft.		
				16. Nearest source of possible contamination: ft. 60 Direction NE Type septic Well disinfected upon completion? <input checked="" type="checkbox"/> Yes <input type="checkbox"/> No		
				17. Pump: <input checked="" type="checkbox"/> Not installed Manufacturer's name Model number HP Volts Length of drop pipe ft. capacity g.p.m. Type: <input type="checkbox"/> Submersible <input type="checkbox"/> Turbine <input type="checkbox"/> Jet <input type="checkbox"/> Reciprocating <input type="checkbox"/> Centrifugal <input type="checkbox"/> Other		
				(Use a second sheet if needed)		
18. Elevation:		19. Remarks:		20. Water well contractor's certification: This well was drilled under my jurisdiction and this report is true to the best of my knowledge and belief. Price Water Well 193 Business name License No. Address RR3 Hutchinson Signed John Danoy Date 6-2-78 Authorized representative		
Topography: <input type="checkbox"/> Hill <input type="checkbox"/> Slope <input checked="" type="checkbox"/> Upland <input checked="" type="checkbox"/> Valley						

Forward the white, blue and pink copies to the Department of Health and Environment

Form WWC-5