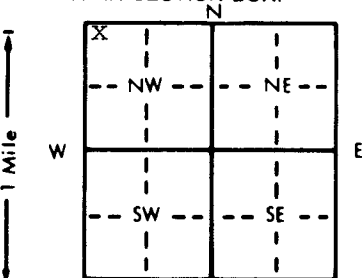


1 LOCATION OF WATER WELL:		Fraction	Section Number		Township Number	Range Number
County: Reno		NW 1/4 NW 1/4 NW 1/4	22		T 22 S	R 6 E/W
Distance and direction from nearest town or city street address of well if located within city? 1/16 of mile South of 69th on Pennington Rd.						
2 WATER WELL OWNER: City of Hutchinson						
RR#, St. Address, Box #: P.O. Box 1567				Board of Agriculture, Division of Water Resources		
City, State, ZIP Code: Hutchinson, Ks. 67504-1567				Application Number:		
3 LOCATE WELL'S LOCATION WITH AN "X" IN SECTION BOX:		4 DEPTH OF COMPLETED WELL: 45 ft. ELEVATION:				
		Depth(s) Groundwater Encountered 1. ft. 2. ft. 3. ft. WELL'S STATIC WATER LEVEL 10 ft. below land surface measured on mo/day/yr 11-9-92 Pump test data: Well water was ft. after hours pumping gpm Est. Yield gpm: Well water was ft. after hours pumping gpm Bore Hole Diameter 5 in. to 50 ft., and in. to ft. WELL WATER TO BE USED AS: 5 Public water supply 8 Air conditioning 11 Injection well 1 Domestic 3 Feedlot 6 Oil field water supply 9 Dewatering 12 Other (Specify below) 2 Irrigation 4 Industrial 7 Lawn and garden only 10 Monitoring well Was a chemical/bacteriological sample submitted to Department? Yes No X If yes, mo/day/yr sample was submitted Water Well Disinfected? Yes X No				
5 TYPE OF BLANK CASING USED: 5 Wrought iron 8 Concrete tile CASING JOINTS: Glued X Clamped 1 Steel 3 RMP (SR) 6 Asbestos-Cement 9 Other (specify below) Welded 2 PVC 4 ABS 7 Fiberglass Threaded Blank casing diameter 2 in. to 25 ft., Dia in. to ft., Dia in. to ft. Casing height above land surface 24 in., weight lbs./ft. Wall thickness or gauge No. 154 TYPE OF SCREEN OR PERFORATION MATERIAL: 7 PVC 10 Asbestos-cement 1 Steel 3 Stainless steel 5 Fiberglass 8 RMP (SR) 11 Other (specify) 2 Brass 4 Galvanized steel 6 Concrete tile 9 ABS 12 None used (open hole) SCREEN OR PERFORATION OPENINGS ARE: 5 Gauzed wrapped 8 Saw cut 11 None (open hole) 1 Continuous slot 3 Mill slot 6 Wire wrapped 9 Drilled holes 2 Louvered shutter 4 Key punched 7 Torch cut 10 Other (specify) SCREEN-PERFORATED INTERVALS: From 25 ft. to 45 ft., From ft. to ft. From ft. to ft., From ft. to ft. GRAVEL PACK INTERVALS: From 45 ft. to 20 ft., From ft. to ft. From ft. to ft., From ft. to ft.						
6 GROUT MATERIAL: 1 Neat cement 2 Cement grout 3 Bentonite 4 Other Hole Plug Grout Intervals: From 20 ft. to 0 ft., From ft. to ft., From ft. to ft. What is the nearest source of possible contamination: 10 Livestock pens 14 Abandoned water well 1 Septic tank 4 Lateral lines 7 Pit privy 11 Fuel storage 15 Oil well/Gas well 2 Sewer lines 5 Cess pool 8 Sewage lagoon 12 Fertilizer storage 16 Other (specify below) 3 Watertight sewer lines 6 Seepage pit 9 Feedyard 13 Insecticide storage NONE Direction from well? How many feet?						
FROM TO		LITHOLOGIC LOG		FROM TO		PLUGGING INTERVALS
0 3		Top soil				
3 7		Brown Clay				
7 24		Sand & gravel				
24 25		Yellow Brown clay				
25 50		Sand & Gravel				
7 CONTRACTOR'S OR LANDOWNER'S CERTIFICATION: This water well was (1) constructed, (2) reconstructed, or (3) plugged under my jurisdiction and was completed on (mo/day/year) 11-9-92 and this record is true to the best of my knowledge and belief. Kansas Water Well Contractor's License No. 134 This Water Well Record was completed on (mo/day/yr) 11-11-92 under the business name of Rosencrantz-Bemis by (signature) Aug Dodson						
INSTRUCTIONS: Use typewriter or ball point pen. PLEASE PRESS FIRMLY and PRINT clearly. Please fill in blanks, underline or circle the correct answers. Send top three copies to Kansas Department of Health and Environment, Bureau of Water, Topeka, Kansas 66620-0001. Telephone: 913-296-5545. Send one to WATER WELL OWNER and retain one for your records.						