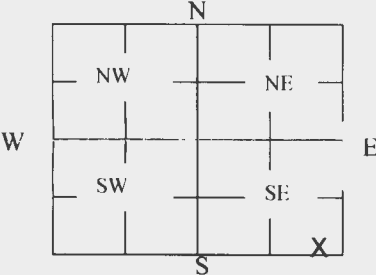


WATER WELL PLUGGING RECORD Form WWC-5P
KSA 82a-1212 ID NO.
Well 15 - WR18341

1 LOCATION OF WATER WELL: County: Reno Fraction: SW 1/4 SE 1/4 SE 1/4 SE 1/4 Section Number: 26 Township Number: T 22 S Range Number: 6 <input type="checkbox"/> E <input checked="" type="checkbox"/> W Street/Rural Address of Well Location; if unknown, distance & direction from nearest town or intersection: If at owner's address, check here <input checked="" type="checkbox"/> From intersection of 43rd Ave. and Monroe St. (SE section corner) 597' west and 88' north	Global Positioning Systems (GPS) information: Latitude: 38.100278 (in decimal degrees) Longitude: -97.942778 (in decimal degrees) Elevation: 1548 Horizontal Datum: <input type="checkbox"/> WGS84, <input checked="" type="checkbox"/> NAD83, <input type="checkbox"/> NAD27 Collection Method: <input type="checkbox"/> GPS unit (Make/Model: _____) <input checked="" type="checkbox"/> Digital Map/Photo, <input checked="" type="checkbox"/> Topographic Map, <input type="checkbox"/> Land Survey Est. Accuracy: <input type="checkbox"/> < 3 m, <input type="checkbox"/> 3-5 m, <input checked="" type="checkbox"/> 5-15 m, <input type="checkbox"/> > 15 m	
2 WATER WELL OWNER: City of Hutchinson RR#, St. Address, Box #: PO Box 1567 City, State ZIP Code: Hutchinson, KS 67504	3 MARK WELL'S LOCATION WITH AN "X" IN SECTION BOX: 	
4 DEPTH OF WELL <u>73</u> ft. WELL'S STATIC WATER LEVEL <u>17</u> ft WELL WAS USED AS: <table style="width:100%;"> <tr> <td><input type="checkbox"/> Domestic</td> <td><input checked="" type="checkbox"/> Public Water Supply</td> <td><input type="checkbox"/> Dewatering</td> </tr> <tr> <td><input type="checkbox"/> Irrigation</td> <td><input type="checkbox"/> Oil Field Water Supply</td> <td><input type="checkbox"/> Monitoring</td> </tr> <tr> <td><input type="checkbox"/> Feedlot</td> <td><input type="checkbox"/> Domestic (Lawn & Garden)</td> <td><input type="checkbox"/> Injection Well</td> </tr> <tr> <td><input type="checkbox"/> Industrial</td> <td><input type="checkbox"/> Air Conditioning</td> <td><input type="checkbox"/> Other _____</td> </tr> </table> Was a chemical/bacteriological sample submitted to Department? Yes <input type="checkbox"/> No <input checked="" type="checkbox"/>		<input type="checkbox"/> Domestic	<input checked="" type="checkbox"/> Public Water Supply	<input type="checkbox"/> Dewatering	<input type="checkbox"/> Irrigation	<input type="checkbox"/> Oil Field Water Supply	<input type="checkbox"/> Monitoring	<input 
5 TYPE OF BLANK CASING USED: <input checked="" type="checkbox"/> Steel <input type="checkbox"/> RMP (SR) <input type="checkbox"/> Wrought <input type="checkbox"/> Fiberglass <input type="checkbox"/> Other (Specify below) _____ <input type="checkbox"/> PVC <input type="checkbox"/> ABS <input type="checkbox"/> Asbestos-Cement <input type="checkbox"/> Concrete Tile Blank casing diameter <u>18</u> in. Was casing pulled? Yes <input type="checkbox"/> No <input type="checkbox"/> If yes, how much _____ Casing height above or below land surface <u>12</u> in.	
6 GROUT PLUG MATERIAL: <input type="checkbox"/> Neat cement <input checked="" type="checkbox"/> Cement grout <input type="checkbox"/> Bentonite <input type="checkbox"/> Other _____ Grout Plug Intervals: From <u>16</u> ft. to <u>3</u> ft., From _____ ft. to _____ ft., From _____ ft. to _____ ft. What is the nearest source of possible contamination: <table style="width:100%;"> <tr> <td><input type="checkbox"/> Septic tank</td> <td><input type="checkbox"/> Seepage pit</td> <td><input type="checkbox"/> Fuel storage</td> <td rowspan="5"><input type="checkbox"/> Other (specify below) _____</td> </tr> <tr> <td><input checked="" type="checkbox"/> Sewer lines</td> <td><input type="checkbox"/> Pit privy</td> <td><input type="checkbox"/> Fertilizer storage</td> </tr> <tr> <td><input type="checkbox"/> Watertight sewer lines</td> <td><input type="checkbox"/> Sewage lagoon</td> <td><input type="checkbox"/> Insecticide storage</td> </tr> <tr> <td><input type="checkbox"/> Lateral lines</td> <td><input type="checkbox"/> Feedyard</td> <td><input type="checkbox"/> Abandoned water well</td> </tr> <tr> <td><input type="checkbox"/> Cess pool</td> <td><input type="checkbox"/> Livestock pens</td> <td><input type="checkbox"/> Oil well/Gas well</td> </tr> </table> Direction from well? <u>South</u> How many feet? <u>260</u>		<input type="checkbox"/> Septic tank	<input type="checkbox"/> Seepage pit	<input type="checkbox"/> Fuel storage	<input type="checkbox"/> Other (specify below) _____	<input checked="" type="checkbox"/> Sewer lines	<input type="checkbox"/> Pit privy	<input type="checkbox"/> Fertilizer storage	<input type="checkbox"/> Watertight 
<table border="1" style="width:100%; border-collapse: collapse;"> <thead> <tr> <th>FROM</th> <th>TO</th> <th>PLUGGING MATERIALS</th> <th>FROM</th> <th>TO</th> <th>PLUGGING MATERIALS</th> </tr> </thead> <tbody> <tr> <td>73</td> <td>16</td> <td>Chlorinated coarse sand and gravel</td> <td></td> <td></td> <td>Well 15 authorized by DWR</td> </tr> <tr> <td>16</td> <td>3</td> <td>Cement grout</td> <td></td> <td></td> <td>Water Right No. 18431</td> </tr> <tr> <td>3</td> <td>2.5</td> <td>Bentonite hole plug (2 bags)</td> <td></td> <td></td> <td></td> </tr> <tr> <td>2.5</td> <td>0.5</td> <td>Sand (fine)</td> <td></td> <td></td> <td></td> </tr> <tr> <td>0.5</td> <td>0</td> <td>Concrete to floor grade inside well</td> <td></td> <td></td> <td>Well 15 located inside well house.</td> </tr> <tr> <td></td> <td></td> <td>house.</td> <td></td> <td></td> <td>Casing removed 1' below well house</td> </tr> <tr> <td></td> <td></td> <td></td> <td></td> <td></td> <td>floor surface.</td> </tr>
7 CONTRACTOR'S OR LANDOWNER'S CERTIFICATION: This water well was plugged under my jurisdiction and was completed on (mo/day/year) <u>7/15/2022</u> and this record is true to the best of my knowledge and belief. Kansas Water Well Contractor's License No. <u>N/A</u> . This Water Well Record was completed on (mo/day/year) <u>7/15/2022</u> under the business name of <u>City of Hutchinson</u> by (signature) <u>[Signature]</u>	

Send one white copy to Kansas Department of Health & Environment, Geology Section, 1000 SW Jackson Street, Ste. 420, Topeka, KS 66612-1367. Send one copy to WATER WELL OWNER and retain one for your records.

Visit us at <http://www.kdheks.gov/waterwell/index.html> Telephone 785-296-5524.

KSA82a-1212
Revised 1/20/2015