

1 LOCATION OF WATER WELL:	Fraction	Section Number	Township Number	Range Number
County: <u>Reno</u>	<u>NE</u> $\frac{1}{4}$ <u>NE</u> $\frac{1}{4}$ <u>SE</u> $\frac{1}{4}$	<u>10</u>	T <u>22</u> S	R <u>7</u> E/W

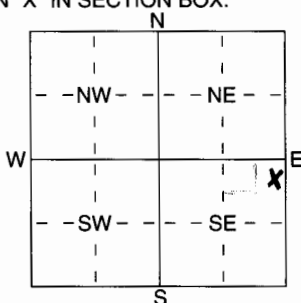
Distance and direction from nearest town or city street address of well if located within city?

8701 N. Riverton Road, Nickerson, Ks.2 WATER WELL OWNER: Henry and Rebecca HartmanRR#, St. Address, Box # : 112 W. First StreetCity, State, ZIP Code : Lyons, Ks. 67554

Board of Agriculture, Division of Water Resources

Application Number:

3 LOCATE WELL'S LOCATION WITH AN "X" IN SECTION BOX:

4 DEPTH OF COMPLETED WELL ..... 35 ..... ft. ELEVATION: .....

Depth(s) Groundwater Encountered 1 ..... ft. 2 ..... ft. 3 ..... ft.

WELL'S STATIC WATER LEVEL ..... 8 ..... ft. below land surface measured on mo/day/yr 9-20-05

Pump test data: Well water was ..... ft. after ..... hours pumping ..... gpm

Est. Yield ..... gpm: Well water was ..... ft. after ..... hours pumping ..... gpm

WELL WATER TO BE USED AS: 5 Public water supply 8 Air conditioning 11 Injection well

1 Domestic 3 Feedlot 6 Oil field water supply 9 Dewatering 12 Other (Specify below)

2 Irrigation 4 Industrial 7 Domestic (lawn &amp; garden) 10 Monitoring well .....

Was a chemical/bacteriological sample submitted to Department? Yes ..... No X ..... If yes, mo/day/yr sample was submittedWater Well Disinfected? Yes X No

5 TYPE OF BLANK CASING USED:

1 Steel 3 RMP (SR) 5 Wrought iron 8 Concrete tile CASING JOINTS: Glued ..... Clamped .....2 PVC 4 ABS 6 Asbestos-Cement 9 Other (specify below) Welded .....Blank casing diameter ..... 5 ..... in. to ..... 25 ..... ft. Dia ..... in. to ..... ft. Dia ..... in. to ..... ft.Casing height above land surface ..... 20 ..... in., weight ..... 160 ..... lbs./ft. Wall thickness or guage No. 214

TYPE OF SCREEN OR PERFORATION MATERIAL:

1 Steel 3 Stainless Steel 5 Fiberglass 7 PVC 10 Asbestos-Cement

2 Brass 4 Galvanized Steel 6 Concrete tile 8 RMP (SR) 11 Other (Specify) .....

SCREEN OR PERFORATION OPENINGS ARE:

1 Continuous slot 3 Mill slot 5 Guazed wrapped 8 Saw cut 11 None (open hole)

2 Louvered shutter 4 Key punched 6 Wire wrapped 9 Drilled holes

SCREEN-PERFORATED INTERVALS: From ..... 25 ..... ft. to ..... 35 ..... ft. From ..... ft. to ..... ft.GRAVEL PACK INTERVALS: From ..... 35 ..... ft. to ..... 10 ..... ft. From ..... ft. to ..... ft.6 GROUT MATERIAL: 1 Neat cement 2 Cement grout 3 Bentonite 4 Other Hole PlugGrout intervals: From ..... 10 ..... ft. to ..... 0 ..... ft. From ..... ft. to ..... ft. From ..... ft. to ..... ft.

What is the nearest source of possible contamination:

1 Septic tank 4 Lateral lines 7 Pit privy 10 Livestock pens 14 Abandoned water well

2 Sewer lines 5 Cess pool 8 Sewage lagoon 11 Fuel storage 15 Oil well/Gas well

3 Watertight sewer lines 6 Seepage pit 9 Feedyard 12 Fertilizer storage 16 Other (specify below)Direction from well? How many feet? NONE

FROM TO LITHOLOGIC LOG FROM TO PLUGGING INTERVALS

0 2 Sandy Top Soil2 5 Silty Tan Clay5 35 Medium Sand7 CONTRACTOR'S OR LANDOWNER'S CERTIFICATION: This water well was (1) constructed (2) reconstructed, or (3) plugged under my jurisdiction and was completed on (mo/day/year) 9-20-05 and this record is true to the best of my knowledge and belief. KansasWater Well Contractor's Licence No 134 This Water Well Record was completed on (mo/day/yr) 9-23-05under the business name of Basencrenzy Bernis Est. by (signature) James Dodson