

1 LOCATION OF WATER WELL: County: <u>Reno</u>	Fraction <u>NW</u> $\frac{1}{4}$ <u>SW</u> $\frac{1}{4}$ <u>NW</u> $\frac{1}{4}$	Section Number <u>19</u>	Township Number T <u>22</u> S	Range Number R <u>7</u> E/W
--	---	-----------------------------	----------------------------------	--------------------------------


Distance and direction from nearest town or city street address of well if located within city?

2 WATER WELL OWNER: Larry White
RR#, St. Address, Box # : 6502 N. Salem Rd.
City, State, ZIP Code : Nickerson, Ks 67

Board of Agriculture, Division of Water Resources
Application Number:

3 LOCATE WELL'S LOCATION WITH AN "X" IN SECTION BOX:

4 DEPTH OF COMPLETED WELL 80 ft. ELEVATION:

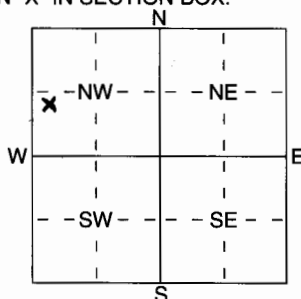

Depth(s) Groundwater Encountered 1 ft. 2 ft. 3 ft.
WELL'S STATIC WATER LEVEL 36 ft. below land surface measured on mo/day/yr 3-8-07
Pump test data: Well water was ft. after hours pumping gpm
Est. Yield gpm: Well water was ft. after hours pumping gpm
WELL WATER TO BE USED AS:
1 Domestic 3 Feedlot 5 Public water supply 8 Air conditioning 11 Injection well
2 Irrigation 4 Industrial 6 Oil field water supply 9 Dewatering 12 Other (Specify below)
7 Domestic (lawn & garden) 10 Monitoring well Druck

Was a chemical/bacteriological sample submitted to Department? Yes No X If yes, mo/day/hrs sample was submitted
Water Well Disinfected? Yes X No

5	TYPE OF BLANK CASING USED
---	---------------------------

5 Wrought iron	8 Concrete tile	CASING JOINTS: <u>Glued</u> Clamped <u>Welded</u> <u>Threaded</u>
6 Asbestos-Cement	9 Other (specify below)	
7 Fiberglass		

Blank casing diameter 5 in. to 60 ft. Dia 214 in. to ft.

Casing height above land surface 20 in., weight 160# lbs./ft. Wall thickness or gauge No.

TYPE OF SCREEN OR PERFORATION MATERIAL:

5 Fiberglass	7 <u>PVC</u>	10 Asbestos-Cement
6 Concrete tile	8 RMP (SR)	11 Other (Specify)
	9 ABS	12 None used (open hole)

SCREEN OR PERFORATION OPENINGS ARE:

5 Guazed wrapped 8 Saw cut 11 None (open hole)
6 Wire wrapped 9 Drilled holes
7 Torch cut 10 Other (specify) ft.

SCREEN-PERFORATED INTERVALS: From 60 ft. to 80 ft., From _____ ft. to _____ ft.

GRAVEL PACK INTERVALS:

6	GROUT MATERIAL:	1 Neat cement	2 Cement grout	3 Bentonite	4 Other <i>Hole Plug</i>
---	-----------------	---------------	----------------	-------------	--------------------------

Grout Intervals: From 20 ft. to 0 ft. From _____ ft. to _____ ft. From _____ ft. to _____ ft.

What is the nearest source of possible contamination:

7 Pit privy	10 Livestock pens	14 <u>Abandoned water well</u>
8 Sewage lagoon	11 Fuel storage	15 Oil well/Gas well
9 Feedyard	12 Fertilizer storage	16 Other (specify below)
	13 Insecticide storage	

Direction from well? *West*

How many feet? 60

[illegible]

7] CONTRACTOR'S OR LANDOWNER'S CERTIFICATION: This water well was (1) constructed, (2) reconstructed, or (3) plugged under my jurisdiction and was completed on (mo/day/year) 3-8-07 and this record is true to the best of my knowledge and belief. Kansas Water Well Contractor's License No. 134 This Water Well Record was completed on (mo/day/yr) 3-16-07 under the business name of Benemerit Ben-Int by (signature) Benemerit Ben-Int