

WATER WELL PLUGGING RECORD Form WWC-5P
KSA 82a-1212
ID NO.

1 LOCATION OF WATER WELL: County: <u>Reno</u>	Fraction <u>NE 1/4 NW 1/4 SE 1/4 NW 1/4</u>	Section Number <u>15</u>	Township Number <u>T 22 S</u>	Range Number <u>7</u> ☐ E ☒ W
---	--	-----------------------------	----------------------------------	---

Street/Rural Address of Well Location; if unknown, distance & direction from nearest town or intersection: If at owner's address, check here ☐

Global Positioning Systems (GPS) information:

Latitude: 38.14093 (in decimal degrees)

Longitude: 98.08087 (in decimal degrees)

Elevation:

Datum: ☐ WGS84, ☐ NAD83, ☒ NAD27

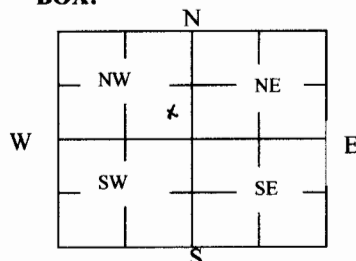
Collection Method:

☐ GPS unit (Make/Model: Garmin csx)

☐ Digital Map/Photo, ☒ Topographic Map, ☐ Land Survey

Est. Accuracy: ☐ < 3 m, ☒ 3-5 m, ☐ 5-15 m, ☐ > 15 m

2 WATER WELL OWNER: Smoky Hill LLC
RR#, St. Address, Box #: 645 E. Crawford Street
City, State ZIP Code: Salina, Kansas 67401

3 MARK WELL'S LOCATION WITH AN "X" IN SECTION BOX:

4 DEPTH OF WELL 28 ft.

WELL'S STATIC WATER LEVEL 9 ft

WELL WAS USED AS:

☐ Domestic
☐ Irrigation
☐ Feedlot
☐ Industrial

☐ Public Water Supply
☐ Oil Field Water Supply
☐ Domestic (Lawn & Garden)
☐ Air Conditioning

☒ Dewatering
☐ Monitoring
☐ Injection Well
☐ Other _____

Was a chemical/bacteriological sample submitted to Department? Yes ☐ No ☒

5 TYPE OF BLANK CASING USED:

☐ Steel ☐ RMP (SR) ☐ Wrought ☐ Fiberglass ☐ Other (Specify below)
☒ PVC ☐ ABS ☐ Asbestos-Cement ☐ Concrete Tile

Blank casing diameter 8 in. Was casing pulled? Yes ☒ No ☐ If yes, how much 28'
Casing height above or below land surface _____ in.

6 GROUT PLUG MATERIAL: ☐ Neat cement ☐ Cement grout ☒ Bentonite ☒ Other Sand

Grout Plug Intervals: From 28 ft. to 8 ft., From 8 ft. to 0 ft., From _____ to _____ ft.

What is the nearest source of possible contamination:

☐ Septic tank ☐ Seepage pit ☐ Fuel Storage ☐ Other (specify below)
☐ Sewer lines ☐ Pit privy ☐ Fertilizer storage
☒ Watertight sewer lines ☐ Sewage lagoon ☐ Insecticide storage
☐ Lateral lines ☐ Feedyard ☐ Abandoned water well
☐ Cess pool ☐ Livestock pens ☐ Oil well/Gas well

Direction from well? East
How many feet? 10'

FROM	TO	PLUGGING MATERIALS	FROM	TO	PLUGGING MATERIALS
0	8	Benonite			
8	28	Sand			

7 CONTRACTOR'S OR LANDOWNER'S CERTIFICATION: This water well was plugged under my jurisdiction and was completed on (mo/day/year) 11-10-10 and this record is true to the best of my knowledge and belief. Kansas Water Well Contractor's License No. 134. This Water Well Record was completed on (mo/day/year) 11-18-10 under the business name of Rosencrantz-Bemis Ent. by (signature) Juan Dodson

INSTRUCTIONS: Use typewriter or ballpoint pen. Please press firmly and print clearly. Please fill in blanks, underline or circle the correct answers. Send top three copies to Kansas Department of Health and Environment, Bureau of Water, Geology Section, 1000 SW Jackson St., Ste. 420, Topeka, Kansas 66612-1367. Telephone: 785/296-5524. Send one to Water Well Owner and retain one for your records. Visit us at <http://www.kdheks.gov/waterwell/index.html>.

Check one: ☒ White Copy ☐ Blue Copy ☐ Pink Copy