

1

BIG BEND GMD#5-KGS
WATER QUALITY
OBSERVATION WELL
NETWORK

SITE NUMBER : 31 (KP6)
SITE LOCATION: NE SE NE


LEGAL LOCATION: 1-22-9W
COUNTY : RENO

WELL LOG

[illegible]

SITE NUMBER : 31 (KP6)
SITE LOCATION : NE SE NE
LEGAL LOCATION: SEC1 T22S R9W
COUNTY : RENO

LANDOWNER: DONNELL AXTELL
ADDRESS : RT. 3
STERLING, KANSAS 67579
PHONE NO.: 316-278-3379
TENANT : HAROLD AXTELL (SON) 278-3471

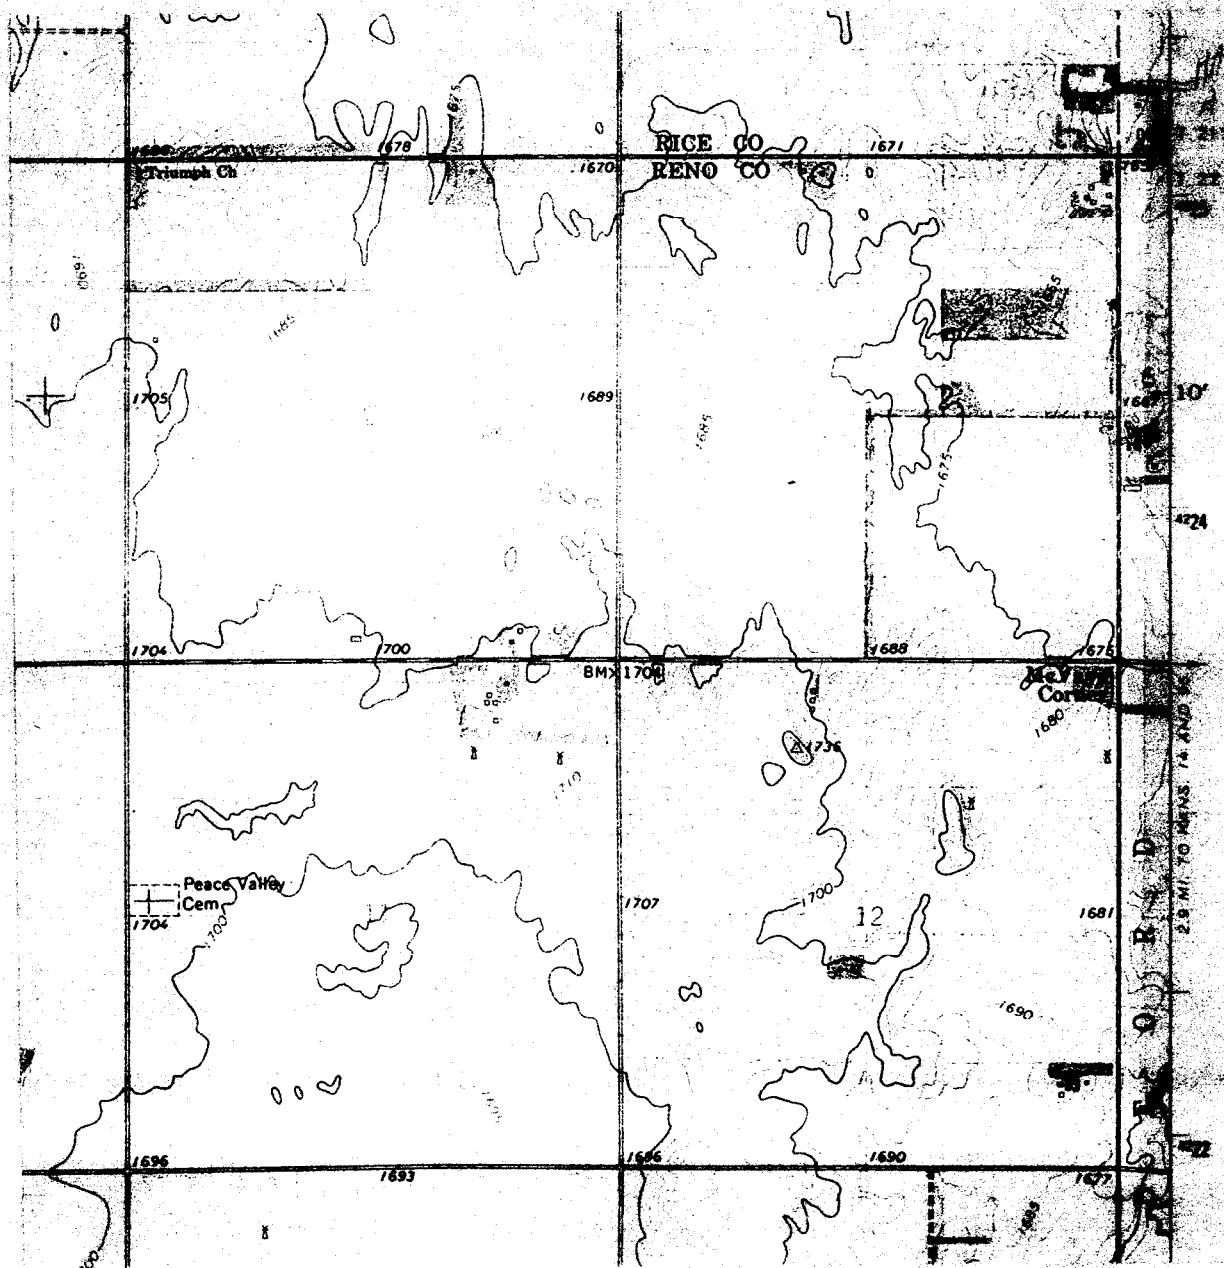

WELL LOCATION *