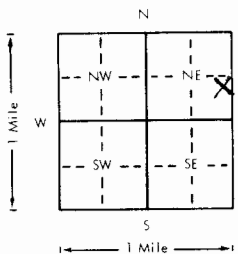


1 LOCATION OF WATER WELL		Fraction	Section Number	Township Number	Range Number
County: Reno		NE 1/4 SE 1/4 NE 1/4	1	T 22 S	R 9 E/W
Distance and direction from nearest town or city? 2 1/2 mi S, 3 mi E from Sterling			Street address of well if located within city?		
2 WATER WELL OWNER: KGS/GWMD#5					
RR#, St. Address, Box # : City, State, ZIP Code :					
Board of Agriculture, Division of Water Resources Application Number:					
3 DEPTH OF COMPLETED WELL: 90 ft. Bore Hole Diameter: 9-7/8 in. to ft., and in. to ft.					
Well Water to be used as: 1 Domestic 3 Feedlot 5 Public water supply 8 Air conditioning 11 Injection well 2 Irrigation 4 Industrial 6 Oil field water supply 9 Dewatering 12 Other (Specify below) Well's static water level: 14.43 ft. below land surface measured on 3 month 1982 year					
Pump Test Data Est. Yield gpm: Well water was ft. after hours pumping gpm Well water was ft. after hours pumping gpm					
4 TYPE OF BLANK CASING USED: 1 Steel 3 RMP (SR) 5 Wrought iron 8 Concrete tile Casing Joints: Glued Clamped 2 PVC 4 ABS 7 Fiberglass 9 Other (specify below) Welded Blank casing dia 5.0 in. to 85 ft. Dia in. to ft. Dia in. to ft. Casing height above land surface 10 in. weight lbs./ft. Wall thickness or gauge No Schd #40					
TYPE OF SCREEN OR PERFORATION MATERIAL: 1 Steel 3 Stainless steel 5 Fiberglass 8 RMP (SR) 10 Asbestos-cement 2 Brass 4 Galvanized steel 6 Concrete tile 9 ABS 11 Other (specify) Screen or Perforation Openings Are: 1 Continuous slot 3 Mill slot 5 Gauzed wrapped 8 Saw cut 11 None (open hole) 2 Louvered shutter 4 Key punched 7 Torch cut 10 Other (specify)					
Screen-Perforation Dia 5.0 in. to ft. Dia in. to ft. Dia in. to ft. Screen-Perforated Intervals: From 85 ft. to 90 ft. From ft. to ft. From ft. to ft. Gravel Pack Intervals: From 82 ft. to 90 ft. From ft. to ft. From ft. to ft.					
5 GROUT MATERIAL: 1 Neat cement 2 Cement grout 3 Bentonite 4 Other					
Grouted Intervals: From 40 ft. to 82 ft. From 0 ft. to 10 ft. From ft. to ft.					
What is the nearest source of possible contamination: Unknown 1 Septic tank 4 Cess pool 7 Sewage lagoon 11 Fertilizer storage 14 Abandoned water well 2 Sewer lines 5 Seepage pit 8 Feed yard 12 Insecticide storage 15 Oil well/Gas well 3 Lateral lines 6 Pit privy 9 Livestock pens 13 Watertight sewer lines 16 Other (specify below)					
Direction from well How many feet ? Water Well Disinfected? Yes (No) Was a chemical/bacteriological sample submitted to Department? Yes (No) If yes, date sample was submitted month day year: Pump Installed? Yes (No) If Yes: Pump Manufacturer's name Model No. HP Volts Depth of Pump Intake ft. Pumps Capacity rated at gal./min. Type of pump: 1 Submersible 2 Turbine 3 Jet 4 Centrifugal 5 Reciprocating 6 Other					
6 CONTRACTOR'S OR LANDOWNER'S CERTIFICATION: This water well was (1) constructed , (2) reconstructed, or (3) plugged under my jurisdiction and was completed on 12 month 3 day 1981 year and this record is true to the best of my knowledge and belief. Kansas Water Well Contractor's License No. This Water Well Record was completed on 5 Sept month 27 day 1983 year under the business name of Kansas Geological Survey by (signature) X Thomas M. Cain					
7 LOCATE WELL'S LOCATION WITH AN "X" IN SECTION BOX:		FROM TO LITHOLOGIC LOG		FROM TO LITHOLOGIC LOG	
		See log from Site #31(1)			
ELEVATION:					
Depth(s) Groundwater Encountered 1. ft. 2. ft. 3. ft. 4. ft. (Use a second sheet if needed)					
INSTRUCTIONS: Use typewriter or ball point pen, please press firmly and PRINT clearly. Please fill in blanks, underline or circle the correct answers. Send top three copies to Kansas Department of Health and Environment, Division of Environment, Water Well Contractors, Topeka, KS 66620. Send one to WATER WELL OWNER and retain one for your records.					

OFFICE USE ONLY

T

R

E/W

SEC.

NE 1/4 SE 1/4 NE 1/4

DP

BIG BEND GMD#5-KGS
WATER QUALITY
OBSERVATION WELL
NETWORK

SITE NUMBER : 31 (KP6)
SITE LOCATION: NE SE NE


LEGAL LOCATION: 1-22-9W
COUNTY : RENO

WELL LOG

[illegible]

SITE NUMBER : 31 (KP6)
SITE LOCATION : NE SE NE
LEGAL LOCATION: SEC1 T22S R9W
COUNTY : RENO

LANDOWNER: DONNELL AXTELL
ADDRESS : RT. 3
STERLING, KANSAS 67579
PHONE NO.: 316-278-3379
TENANT : HAROLD AXTELL (SON) 278-3471

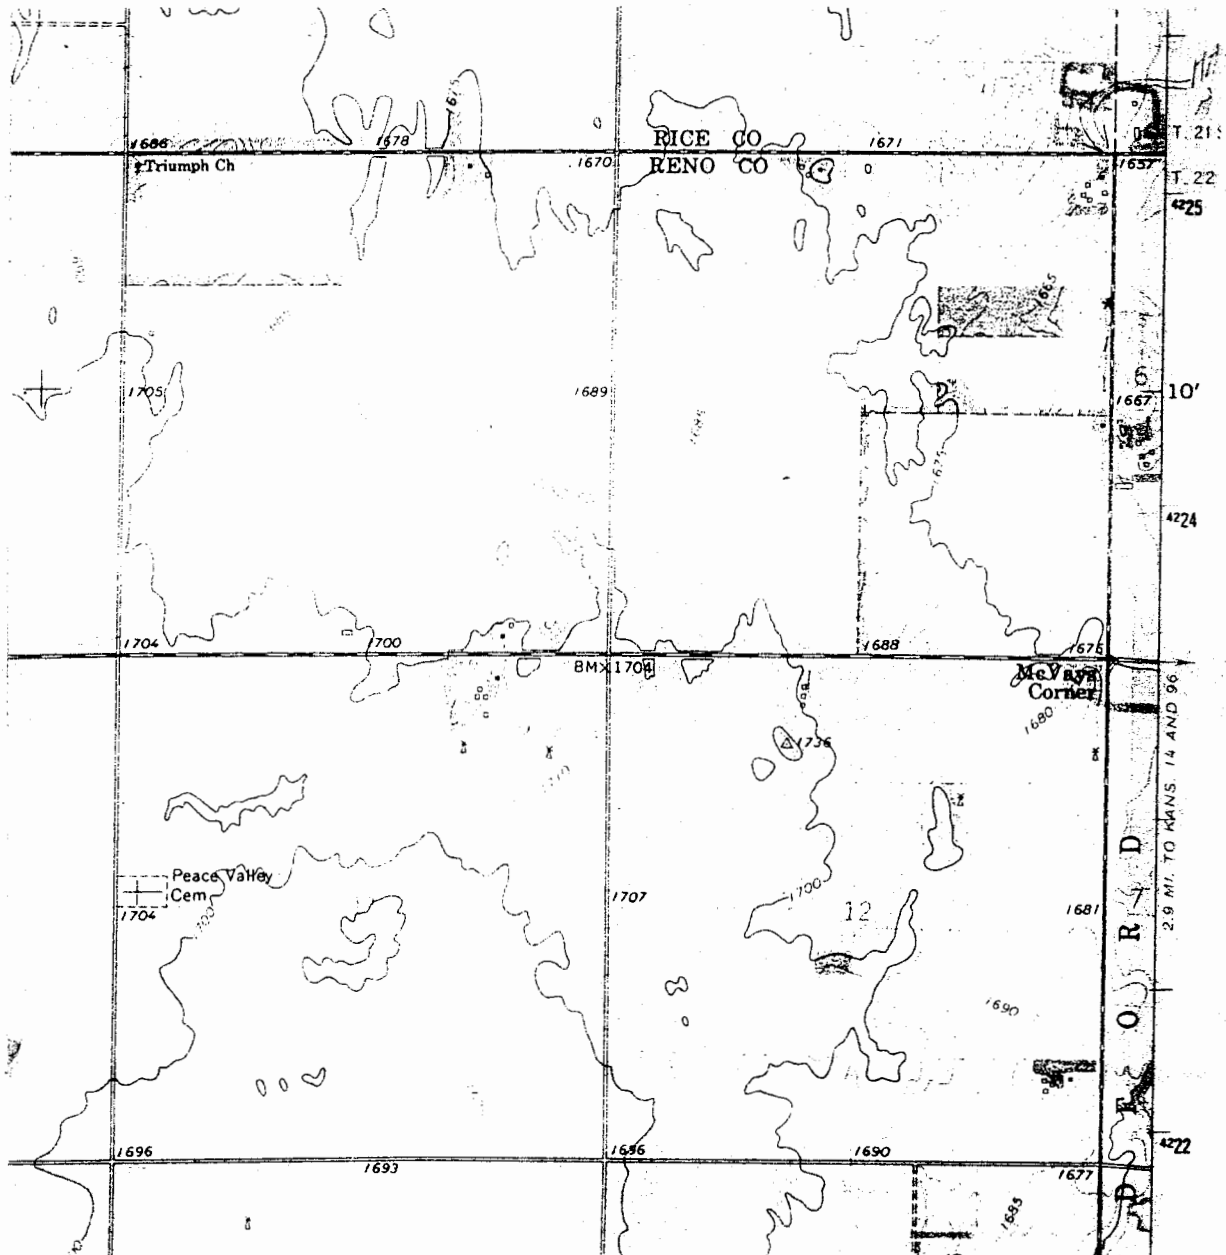

WELL LOCATION *