

1 LOCATION OF WATER WELL:	Fraction	Section Number	Township Number	Range Number
County: <u>Harvey</u>	<u>SW 1/4 SW 1/4 NW 1/4</u>	<u>24</u>	T <u>23</u> S	R <u>1</u> EW


Distance and direction from nearest town or city street address of well if located within city?

1 mi W of Newton - 606 Mockingbird

2 WATER WELL OWNER:	Board of Agriculture, Division of Water Resources
RR#, St. Address, Box # :	Application Number:
City, State, ZIP Code :	

Gerhard Neufeld606 MockingbirdNewton, KS 67114

3 LOCATE WELL'S LOCATION WITH AN "X" IN SECTION BOX:	4 DEPTH OF COMPLETED WELL: <u>65</u> ft. ELEVATION:
--	---

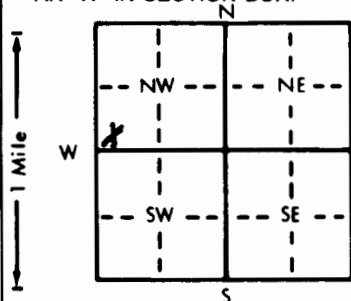

Depth(s) Groundwater Encountered 1. ft. 2. ft. 3. ft.

WELL'S STATIC WATER LEVEL 14 ft. below land surface measured on mo/day/yr 4-19-96Pump test data: Well water was 60 ft. after 1 hours pumping 18 gpmEst. Yield 18 gpm: Well water was . . . ft. after . . . hours pumping . . . gpmBore Hole Diameter 8 in. to 34 ft. and 5 1/2 in. to 65 ft.

WELL WATER TO BE USED AS: 5 Public water supply 8 Air conditioning 11 Injection well

1 Domestic 3 Feedlot 6 Oil field water supply 9 Dewatering 12 Other (Specify below)

2 Irrigation 4 Industrial 7 Lawn and garden only 10 Monitoring wellWas a chemical/bacteriological sample submitted to Department? Yes X No X; If yes, mo/day/yr sample was sub-mitted Water Well Disinfected? Yes No

5 TYPE OF BLANK CASING USED:	5 Wrought iron	8 Concrete tile	CASING JOINTS: Glued <u>X</u> Clamped
------------------------------	----------------	-----------------	---

1 Steel 3 RMP (SR) 6 Asbestos-Cement 9 Other (specify below) Welded

2 PVC 4 ABS 7 Fiberglass ThreadedBlank casing diameter 5 in. to 16 ft. Dia 5 in. to 34 ft. Dia . . . in. to . . . ft.Casing height above land surface 12 in. weight 2.21 lbs./ft. Wall thickness or gauge No. 160TYPE OF SCREEN OR PERFORATION MATERIAL: 7 PVC 10 Asbestos-cement

1 Steel 3 Stainless steel 5 Fiberglass 8 RMP (SR) 11 Other (specify)

2 Brass 4 Galvanized steel 6 Concrete tile 9 ABS 12 None used (open hole)

SCREEN OR PERFORATION OPENINGS ARE: 5 Gauzed wrapped 8 Saw cut X 11 None (open hole)

1 Continuous slot 3 Mill slot 6 Wire wrapped 9 Drilled holes

2 Louvered shutter 4 Key punched 7 Torch cut 10 Other (specify)

SCREEN-PERFORATED INTERVALS: From 16 ft. to 30 ft. From . . . ft. to . . . ft.

From . . . ft. to . . . ft. From . . . ft. to . . . ft.

GRAVEL PACK INTERVALS: From 14 ft. to 31 ft. From . . . ft. to . . . ft.

From . . . ft. to . . . ft. From . . . ft. to . . . ft.

6 GROUT MATERIAL:	1 Neat cement	2 Cement grout	<u>3</u> Bentonite	4 Other
-------------------	---------------	----------------	--------------------	-------------------

Grout Intervals: From 0 ft. to 14 ft. From 31 ft. to 34 ft. From . . . ft. to . . . ft.

What is the nearest source of possible contamination: 10 Livestock pens 14 Abandoned water well

1 Septic tank 4 Lateral lines 7 Pit privy 11 Fuel storage 15 Oil well/Gas well

2 Sewer lines 5 Cess pool 8 Sewage lagoon 12 Fertilizer storage 16 Other (specify below)

3 Watertight sewer lines 6 Seepage pit 9 Feedyard 13 Insecticide storageDirection from well? S How many feet? 40

FROM TO LITHOLOGIC LOG FROM TO PLUGGING INTERVALS

0 10 Rocky Br Clay10 29 Sand - F-M29 65 Shale

7 CONTRACTOR'S OR LANDOWNER'S CERTIFICATION: This water well was <u>(1)</u> constructed, (2) reconstructed, or (3) plugged under my jurisdiction and was completed on (mo/day/year) <u>4-19-96</u> and this record is true to the best of my knowledge and belief. Kansas

Water Well Contractor's License No. 447 This Water Well Record was completed on (mo/day/yr) 5-11-96under the business name of Miller Drilling by (signature) G. Miller