WATER WELL RECORD Form WWC-5 KSA 82a-1212

1 LOCATION OF WATER WELL:	Fraction	Section Number	Township Number	Range Number
County: HARVEY	SW ¼ SE ¼ SW ¼	2	T 23 S	R 1 E (W)

Distance and direction from nearest town or city street address of well if located within city?
1 North & 1 1/2 West of Newton

2 WATER WELL OWNER: JAMES DAVIS
RR#, St. Address, Box # : RR#1
City, State, ZIP Code : NEWTON, KS 67114

Board of Agriculture, Division of Water Resources
Application Number:

3 LOCATE WELL'S LOCATION WITH AN "X" IN SECTION BOX:

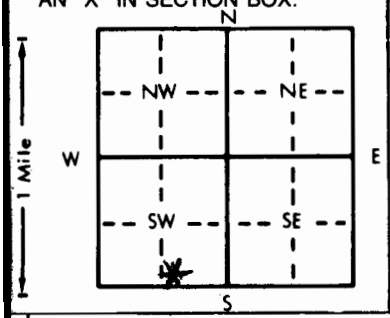

4 DEPTH OF COMPLETED WELL 45 ft. ELEVATION:
Depth(s) Groundwater Encountered 1. 25 ft. 2. ft. 3. 11-10-82 ft.
WELL'S STATIC WATER LEVEL 18 ft. below land surface measured on mo/day/yr 11-10-82
Pump test data: Well water was 23 ft. after 1 hours pumping 20 gpm
Est. Yield 20/25 gpm: Well water was ft. after hours pumping gpm
Bore Hole Diameter 11 in. to 45' ft., and in. to ft.
WELL WATER TO BE USED AS: 1 Domestic (circled) 2 Irrigation 3 Feedlot 4 Industrial 5 Public water supply 6 Oil field water supply 7 Lawn and garden only 8 Air conditioning 9 Dewatering 10 Observation well 11 Injection well 12 Other (Specify below)
Was a chemical/bacteriological sample submitted to Department? Yes ..... No X ; If yes, mo/day/yr sample was submitted
Water Well Disinfected? Yes (circled) X No

5 TYPE OF BLANK CASING USED: 1 Steel 2 PVC (circled) 3 RMP (SR) 4 ABS 5 Wrought iron 6 Asbestos-Cement 7 Fiberglass 8 Concrete tile 9 Other (specify below)
CASING JOINTS: Glued X Clamped Welded Threaded
Blank casing diameter 5 in. to 25 ft., Dia in. to ft., Dia in. to ft.
Casing height above land surface 18 in., weight 2.37 lbs./ft. Wall thickness or gauge No. .214
TYPE OF SCREEN OR PERFORATION MATERIAL: 1 Steel 2 Brass 3 Stainless steel 4 Galvanized steel 5 Fiberglass 6 Concrete tile 7 PVC (circled) 8 RMP (SR) 9 ABS 10 Asbestos-cement 11 Other (specify) 12 None used (open hole)
SCREEN OR PERFORATION OPENINGS ARE: 1 Continuous slot 2 Louvered shutter 3 Mill slot 4 Key punched 5 Gauzed wrapped .025 6 Wire wrapped 7 Torch cut 8 Saw cut (circled) Factory 9 Drilled holes 10 Other (specify) 11 None (open hole)
SCREEN-PERFORATED INTERVALS: From 25' ft. to 45' ft., From ft. to ft.
From ft. to ft., From ft. to ft.
GRAVEL PACK INTERVALS: From 10 ft. to 45 ft., From ft. to ft.
From ft. to ft., From ft. to ft.

6 GROUT MATERIAL: 1 Neat cement 2 Cement grout 3 Bentonite (circled) 4 Other
Grout Intervals: From 0 ft. to 10 ft., From ft. to ft., From ft. to ft.
What is the nearest source of possible contamination:
1 Septic tank 2 Sewer lines 3 Watertight sewer lines 4 Lateral lines 5 Cess pool 6 Seepage pit 7 Pit privy 8 Sewage lagoon 9 Feedyard (circled) 10 Livestock pens 11 Fuel storage 12 Fertilizer storage 13 Insecticide storage 14 Abandoned water well 15 Oil well/Gas well 16 Other (specify below)
Direction from well? EAST How many feet? 50'

FROM	TO	LITHOLOGIC LOG	FROM	TO	LITHOLOGIC LOG
0	5	Loam to red br. sandy clay			
5	15	red brown clay			
15	24	Light brown to sandy br. clay			
24	30	Sand w/clays med fine			
30	31	Clay Seam			
31	38	Sand medium			
38	40	green Shale			
40	45	grey Shale to Dark			

7 CONTRACTOR'S OR LANDOWNER'S CERTIFICATION: This water well was (1) constructed (circled), (2) reconstructed, or (3) plugged under my jurisdiction and was completed on (mo/day/year) 11-10-82 and this record is true to the best of my knowledge and belief. Kansas Water Well Contractor's License No. 175 This Water Well Record was completed on (mo/day/yr) 12-15-82 under the business name of PAUL'S INC. by (signature) Paul Burchett

INSTRUCTIONS: Use typewriter or ball point pen, *PLEASE PRESS FIRMLY* and *PRINT* clearly. Please fill in blanks, underline or circle the correct answers. Send top three copies to Kansas Department of Health and Environment, Division of Environment, Environmental Geology Section, Topeka, KS 66620. Send one to WATER WELL OWNER and retain one for your records.

OFFICE USE ONLY T 23 R 1 E (W) SEC. 2 SW ¼ SE ¼ SW ¼