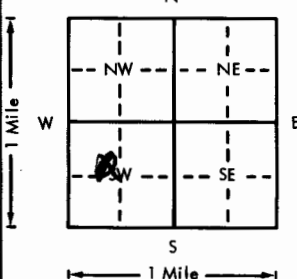
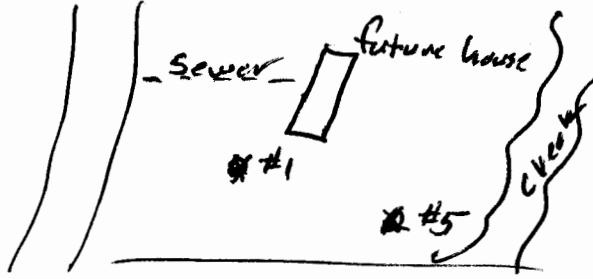


USE TYPEWRITER OR BALL  
POINT PEN-PRESS FIRMLY,  
PRINT CLEARLY.

WATER WELL RECORD  
KSA 82a-1201-1215

Kansas Department of Health and  
Environment-Division of Environment  
(Water well Contractors)  
Topeka, Kansas 66620

1. Location of well:	County <b>HARVEY</b>	Fraction <b>SE 1/4 NW 1/4 SW 1/4</b>	Section number <b>24</b>	Township number <b>T 23 S</b>	Range number <b>R 1 E</b>
2. Distance and direction from nearest town or city: Street address of well location if in city	<b>Lot #3 Royer West ADD - Newton</b>		3. Owner of well: R.R. or street: City, state, zip code:	<b>VERNON King 212 SB 5th Newton, KS</b>	
4. Locate with "X" in section below:	Sketch map:		6. Bore hole dia. <b>4</b> in. Completion date <b>8-12-78</b> Well depth <b>91</b> ft.		
			7. Cable tool <input checked="" type="checkbox"/> Rotary <input type="checkbox"/> Driven <input type="checkbox"/> Dug <input type="checkbox"/> Hollow rod <input type="checkbox"/> Jetted <input type="checkbox"/> Bored <input type="checkbox"/> Reverse rotary		
5. Type and color of material	From	To	8. Use: <input checked="" type="checkbox"/> Domestic <input type="checkbox"/> Public supply <input type="checkbox"/> Industry <input type="checkbox"/> Irrigation <input type="checkbox"/> Air conditioning <input type="checkbox"/> Stock <input type="checkbox"/> Lawn <input type="checkbox"/> Oil field water <input type="checkbox"/> Other		
<b>Silty LOAM</b>	<b>0</b>	<b>3</b>	9. Casing: Material <b>Plastic</b> Height <b>Above</b> or below Threaded <input type="checkbox"/> Welded <input checked="" type="checkbox"/> Surface <b>24</b> in. RMP <input type="checkbox"/> PVC <input checked="" type="checkbox"/> Weight <b>2.82</b> lbs./ft. Dia. <b>5</b> in. to <b>91</b> ft. depth Wall Thickness: inches or Dia. <input type="checkbox"/> in. to <input type="checkbox"/> ft. depth gage No. <b>125B</b>		
<b>SANDY LOAM (Silty)</b>	<b>3</b>	<b>8</b>	10. Screen: Manufacturer's name <b>Kam-Tec</b> Type <b>PVC</b> Dia. <b>5 1/4</b> Slot/gauze <b>1020</b> Length <b>20'</b> Set between <b>18</b> ft. and <b>23</b> ft. <b>35</b> ft. and <b>40</b> ft. <b>+ 80-90</b>		
<b>BROWN CLAY</b>	<b>8</b>	<b>15</b>	Gravel pack? <input checked="" type="checkbox"/> Size range of material <b>4/20</b>		
<b>SANDY CLAY</b>	<b>15</b>	<b>20</b>	11. Static water level: <input type="checkbox"/> mo./day/yr. <b>5</b> ft. below land surface Date <b>8/26/78</b>		
<b>GREEN-GRAY SHALE</b>	<b>20</b>	<b>22</b>	12. Pumping level below land surfaces: <b>93</b> ft. after <b>4</b> hrs. pumping <b>6</b> g.p.m. <input type="checkbox"/> ft. after <input type="checkbox"/> hrs. pumping <input type="checkbox"/> g.p.m. Estimated maximum yield <b>6/8</b> g.p.m.		
<b>GRAY SHALE</b>	<b>22</b>	<b>25</b>	13. Water sample submitted: <input type="checkbox"/> Yes <input checked="" type="checkbox"/> No Date <input type="checkbox"/> mo./day/yr.		
<b>DARK SHALE (WELL)</b>	<b>25</b>	<b>35</b>	14. Well head completion: <input checked="" type="checkbox"/> Pitless adapter <b>30</b> inches above grade		
<b>FAULTED AREA</b>	<b>35</b>	<b>40</b>	15. Well grouted? <input checked="" type="checkbox"/> With: <input checked="" type="checkbox"/> Neat cement <input type="checkbox"/> Bentonite <input type="checkbox"/> Concrete Depth: From <b>10</b> ft. to <b>0</b> ft.		
<b>DARK SHALE</b>	<b>40</b>	<b>52</b>	16. Nearest source of possible contamination: ft. <b>20</b> Direction <b>EAST</b> Type <b>Creek</b> Well disinfected upon completion? <input checked="" type="checkbox"/> Yes <input type="checkbox"/> No		
<b>HARD LIME ROCK</b>	<b>52</b>	<b>54</b>	17. Pump: <input checked="" type="checkbox"/> Not installed Manufacturer's name <input type="checkbox"/> Model number <input type="checkbox"/> HP <input type="checkbox"/> Volts <input type="checkbox"/> Length of drop pipe <input type="checkbox"/> ft. capacity <input type="checkbox"/> g.p.m. Type: <input type="checkbox"/> Submersible <input type="checkbox"/> Turbine <input type="checkbox"/> Jet <input type="checkbox"/> Reciprocating <input type="checkbox"/> Centrifugal <input type="checkbox"/> Other		
<b>DARK SHALE (WELL)</b>	<b>54</b>	<b>64</b>			
<b>FAULT</b>	<b>64</b>				
<b>DARK SHALE (WELL)</b>	<b>64</b>	<b>84</b>			
<b>FAULT</b>	<b>84</b>				
<b>DARK SHALE (WELL)</b>	<b>84</b>	<b>93</b>			
(Use a second sheet if needed)					
18. Elevation:	19. Remarks:		20. Water well contractor's certification: This well was drilled under my jurisdiction and this report is true to the best of my knowledge and belief. <b>PAUL'S INC #125</b> Business name <b>HESSON KS</b> License No. Address <b>Paul Bent</b> Date <b>9/12/78</b> Signed <b>Paul Bent</b> Authorized representative		