

1 LOCATION OF WATER WELL:	Fraction	Section Number	Township Number	Range Number
County: <u>Harvey</u>	<u>SW</u> $\frac{1}{4}$ <u>NE</u> $\frac{1}{4}$ <u>NW</u> $\frac{1}{4}$	<u>24</u>	T <u>23</u> S	R <u>1</u> E <u>(W)</u>

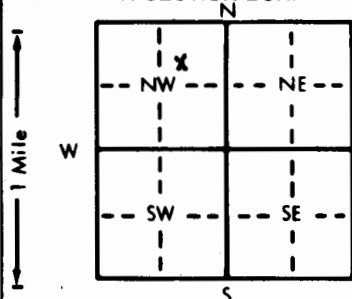
Distance and direction from nearest town or city street address of well if located within city?

1/2 mile West of the intersection of 1st & Meridian; Moorlands Drive2 WATER WELL OWNER: Marie PartridgeRR#, St. Address, Box # : 613 MeridianCity, State, ZIP Code : Newton, KS

Board of Agriculture, Division of Water Resources

Application Number:

3 LOCATE WELL'S LOCATION WITH AN "X" IN SECTION BOX:

4 DEPTH OF COMPLETED WELL: 25.0 ft. ELEVATION:Depth(s) Groundwater Encountered 1 13 ft. 2. ft. 3. ft.WELL'S STATIC WATER LEVEL 3.13 ft. below land surface measured on mo/day/yr 3/24/92

Pump test data: Well water was ft. after hours pumping gpm

Est. Yield gpm: Well water was ft. after hours pumping gpm

Bore Hole Diameter. in. to ft., and in. to ft.

WELL WATER TO BE USED AS: 5 Public water supply 8 Air conditioning 11 Injection well

1 Domestic 3 Feedlot 6 Oil field water supply 9 Dewatering 12 Other (Specify below)

2 Irrigation 4 Industrial 7 Lawn and garden only 10 Monitoring well #2

Was a chemical/bacteriological sample submitted to Department? Yes. No.; If yes, mo/day/yr sample was sub

mitted Water Well Disinfected? Yes No ✓

5 TYPE OF BLANK CASING USED:

1 Steel

3 RMP (SR)

5 Wrought iron

8 Concrete tile

CASING JOINTS: Glued Clamped

2 PVC

4 ABS

6 Asbestos-Cement

9 Other (specify below)

Welded

Blank casing diameter 2 in. to 5.0 ft., Dia in. to ft., Dia in. to ft.Casing height above land surface 36 in., weight lbs./ft. Wall thickness or gauge No. Sch 40

TYPE OF SCREEN OR PERFORATION MATERIAL:

1 Steel

3 Stainless steel

5 Fiberglass

7 PVC

10 Asbestos-cement

2 Brass

4 Galvanized steel

6 Concrete tile

8 RMP (SR)

11 Other (specify)

SCREEN OR PERFORATION OPENINGS ARE:

5 Gauzed wrapped

8 Saw cut

11 None (open hole)

1 Continuous slot

3 Mill slot

6 Wire wrapped

9 Drilled holes

2 Louvered shutter

4 Key punched

7 Torch cut

10 Other (specify)

SCREEN-PERFORATED INTERVALS: From 5.0 ft. to 25.0 ft., From ft. to ft.

From ft. to ft., From ft. to ft.

GRAVEL PACK INTERVALS: From 4.0 ft. to 25.0 ft., From ft. to ft.

From ft. to ft., From ft. to ft.

6 GROUT MATERIAL:

1 Neat cement

2 Cement grout

3 Bentonite

4 Other

Grout Intervals: From 0.5 ft. to 4.0 ft., From ft. to ft., From ft. to ft.

What is the nearest source of possible contamination:

1 Septic tank

4 Lateral lines

7 Pit privy

10 Livestock pens

14 Abandoned water well

2 Sewer lines

5 Cess pool

8 Sewage lagoon

11 Fuel storage

15 Oil well/Gas well

3 Watertight sewer lines

6 Seepage pit

9 Feedyard

12 Fertilizer storage

16 Other (specify below)

Direction from well? NorthHow many feet? 3

FROM	TO	LITHOLOGIC LOG	FROM	TO	PLUGGING INTERVALS
0	3.0	FILL MATERIAL; DK GRAYISH BR CL, SANDY & SILTY			
3.0	4.0	ALLUVIUM; BR SAND, fine to med grained			
4.0	12.0	DK BLuish GRAY CLAYEY SAND			
12.0	13.0	DK BLuish GRAY CLAY			
13.0	16.5	GR CLAY			
16.5	20.5	LT. GRAY CLAYEY SAND			
20.5	25.0	BR fine gr Sand with interbedded gray clay seams.			

7 CONTRACTOR'S OR LANDOWNER'S CERTIFICATION: This water well was (1) constructed, (2) reconstructed, or (3) plugged under my jurisdiction and was completed on (mo/day/year) 3/23/92 and this record is true to the best of my knowledge and belief. KansasWater Well Contractor's License No. 531 This Water Well Record was completed on (mo/day/yr) 3/31/92 under the business name of Geotechnical Services, Inc by (signature) Sandra Hinde Wallace