

1 LOCATION OF WATER WELL:	Fraction	Section Number	Township Number	Range Number
County: <u>Harvey</u>	<u>NE</u> $\frac{1}{4}$ <u>SW</u> $\frac{1}{4}$ <u>NW</u> $\frac{1}{4}$	<u>24</u>	T <u>23</u> S	R <u>1</u> <u>EW</u>


Distance and direction from nearest town or city street address of well if located within city?

West edge Newton

2 WATER WELL OWNER: Jim Stephan  
 RR#, St. Address, Box # : 3220 Hidden Meadows  
 City, State, ZIP Code : Norton, KS 67444

Board of Agriculture, Division of Water Resources  
 Application Number:

3 LOCATE WELL'S LOCATION WITH AN "X" IN SECTION BOX: 4 DEPTH OF COMPLETED WELL..... 33' ft. ELEVATION: .....

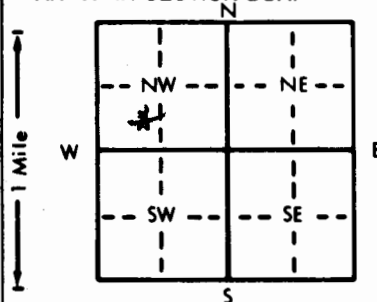

Depth(s) Groundwater Encountered 1. 19 ft. 2. 19 ft. 3. 19 ft.  
WELL'S STATIC WATER LEVEL 19 ft. below land surface measured on mo/day/yr 9-16-88  
Pump test data: Well water was 33 ft. after 1 hours pumping 20+ gpm  
Est. Yield 15 gpm: Well water was 33 ft. after 1 hours pumping 20+ gpm  
Bore Hole Diameter 11 in. to 33 ft., and 33 in. to 33 ft.  
WELL WATER TO BE USED AS:  
5 Public water supply 8 Air conditioning 11 Injection well  
1 Domestic 3 Feedlot 6 Oil field water supply 9 Dewatering 12 Other (Specify below)  
2 Irrigation 4 Industrial 7 Lawn and garden only 10 Observation well  
Was a chemical/bacteriological sample submitted to Department? Yes X No X; If yes, mo/day/yr sample was submitted  
Water Well Disinfected? Yes X No X

5 TYPE OF BLANK CASING USED: 5 Wrought iron 8 Concrete tile CASING JOINTS: Glued ☒ Clamped ☐  
1 Steel 3 RMP (SR) 6 Asbestos-Cement 9 Other (specify below) Welded ☐  
2 PVC 4 ABS 7 Fiberglass Threaded ☐  
Blank casing diameter 5" in. to 23 ft. Dia in. to ft. Dia in. to ft.  
Casing height above land surface 18 in. weight 2.37 lbs./ft. Wall thickness or gauge No. 214

TYPE OF SCREEN OR PERFORATION MATERIAL:

1 Steel	3 Stainless steel	5 Fiberglass	7 PVC	10 Asbestos-cement
2 Brass	4 Galvanized steel	6 Concrete tile	8 RMP (SR)	11 Other (specify) .....
			9 ABS	12 None used (open hole)

SCREEN OR PERFORATION OPENINGS ARE:

1 Continuous slot	3 Mill slot	5 Gauzed wrapped	8 Saw cut	10 30	11 None (open hole)
2 Louvered shutter	4 Key punched	6 Wire wrapped	9 Drilled holes		
		7 Torch cut	10 Other (specify)		

SCREEN-PERFORATED INTERVALS: From . . . . . ft. to . . . . . ft., From . . . . . ft. to . . . . . ft.  
From . . . . . ft. to . . . . . ft., From . . . . . ft. to . . . . . ft.  
GRAVEL PACK INTERVALS: From . . . . . 17 ft. to . . . . . 33 ft., From . . . . . ft. to . . . . . ft.  
From . . . . . ft. to . . . . . ft., From . . . . . ft. to . . . . . ft.

6 GROUT MATERIAL: 1 Neat cement 2 Cement grout 3 Bentonite 4 Other . . . . .  
Grout Intervals: From 0 ft. to 17 ft. From . . . . . ft. to . . . . . ft. From . . . . . ft. to . . . . . ft.

What is the nearest source of possible contamination:

1 Septic tank	4 Lateral lines	7 Pit privy	10 Livestock pens	14 Abandoned water well
2 Sewer lines	5 Cess pool	8 Sewage lagoon	11 Fuel storage	15 Oil well/Gas well
3 Watertight sewer lines	6 Seepage pit	9 Feedyard	12 Fertilizer storage	16 Other (specify below)
			13 Insecticide storage	.....

Direction from well? *120'* *South* How many feet? *120'*

[illegible]

7 CONTRACTOR'S OR LANDOWNER'S CERTIFICATION: This water well was (1) constructed, (2) reconstructed, or (3) plugged under my jurisdiction and was completed on (mo/day/year) 9-16-88 and this record is true to the best of my knowledge and belief. Kansas Water Well Contractor's License No. ~~445~~ 457 This Water Well Record was completed on (mo/day/yr) 10-3-88 under the business name of United Water Well & Pump by (signature) Paul Bernhardt

INSTRUCTIONS: Use typewriter or ball point pen. PLEASE PRESS FIRMLY and PRINT clearly. Please fill in blanks, underline or circle the correct answers. Send top three copies to Kansas Department of Health and Environment, Bureau of Water Protection, Topeka, Kansas 66620-7320, Telephone: 913-862-9360. Send one to WATER WELL OWNER and retain one for your records.