


1 LOCATION OF WATER WELL: County: Harvey Fraction: NE 1/4 SW 1/4 NW 1/4 Section Number: 24 Township Number: T 23 S Range Number: R 1 EW

Distance and direction from nearest town or city street address of well if located within city?

West edge of Newton

2 WATER WELL OWNER: Jerry Kassitz  
RR#, St. Address, Box #: 3201 Morning Dove Lane (Hidden Meadows) Board of Agriculture, Division of Water Resources  
City, State, ZIP Code: Newton, KS 67114 Application Number:

3 LOCATE WELL'S LOCATION WITH AN "X" IN SECTION BOX: 4 DEPTH OF COMPLETED WELL: 33' ft. ELEVATION: 8-17-88

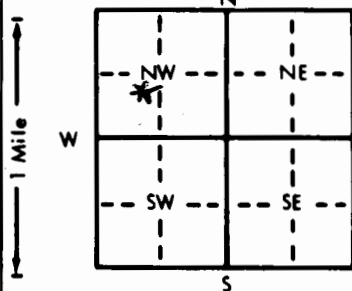

Depth(s) Groundwater Encountered 1. 20' ft. 2. 20' ft. 3. 20' ft.

WELL'S STATIC WATER LEVEL 19' ft. below land surface measured on mo/day/yr 8-17-88

Pump test data: Well water was 33 ft. after 2 hours pumping 10 gpm

Est. Yield 10+ gpm: Well water was 33 ft. after 2 hours pumping 10 gpm

Bore Hole Diameter 11 in. to 33 ft., and 33 in. to 33 ft.

WELL WATER TO BE USED AS: 5 Public water supply 8 Air conditioning 11 Injection well

1 Domestic 3 Feedlot 6 Oil field water supply 9 Dewatering 12 Other (Specify below)

2 Irrigation 4 Industrial 7 Lawn and garden only 10 Observation well

Was a chemical/bacteriological sample submitted to Department? Yes X No X; If yes, mo/day/yr sample was submitted

Water Well Disinfected? Yes X No X

5 TYPE OF BLANK CASING USED: 5 Wrought iron 8 Concrete tile CASING JOINTS: Glued X Clamped X

1 Steel 3 RMP (SR) 6 Asbestos-Cement 9 Other (specify below) Welded X

2 PVC 4 ABS 7 Fiberglass Threaded X

Blank casing diameter 5" in. to 23 ft., Dia. 23 in. to 23 ft., Dia. 23 in. to 23 ft.

Casing height above land surface 24 in., weight 2.37 lbs./ft. Wall thickness or gauge No. 2/14

TYPE OF SCREEN OR PERFORATION MATERIAL: 7 PVC 10 Asbestos-cement

1 Steel 3 Stainless steel 5 Fiberglass 8 RMP (SR) 11 Other (specify)

2 Brass 4 Galvanized steel 6 Concrete tile 9 ABS 12 None used (open hole)

SCREEN OR PERFORATION OPENINGS ARE: 5 Gauzed wrapped 8 Saw cut 11 None (open hole)

1 Continuous slot 3 Mill slot 6 Wire wrapped 9 Drilled holes

2 Louvered shutter 4 Key punched 7 Torch cut 10 Other (specify)

SCREEN-PERFORATED INTERVALS: From 23 ft. to 33 ft., From 23 ft. to 33 ft., From 23 ft. to 33 ft.


GRAVEL PACK INTERVALS: From 20 ft. to 33 ft., From 20 ft. to 33 ft., From 20 ft. to 33 ft.


6 GROUT MATERIAL: 1 Neat cement 2 Cement grout 3 Bentonite 4 Other

Grout Intervals: From 0 ft. to 20 ft., From 0 ft. to 20 ft., From 0 ft. to 20 ft.

What is the nearest source of possible contamination: 10 Livestock pens 14 Abandoned water well

1 Septic tank 4 Lateral lines 7 Pit privy 11 Fuel storage 15 Oil well/Gas well

2 Sewer lines 5 Cess pool 8 Sewage lagoon 12 Fertilizer storage 16 Other (specify below)

3 Watertight sewer lines 6 Seepage pit 9 Feedyard 13 Insecticide storage

Direction from well? West How many feet? 53'

FROM TO LITHOLOGIC LOG FROM TO LITHOLOGIC LOG

0 5 Loam to brown clay  
5 10 red-brown clay  
10 16 light brown clay  
16 21 " " " w/ fine sand  
21 25 fine sand  
25 29 med sand - fine coarse  
29 33 green-grey shale

7 CONTRACTOR'S OR LANDOWNER'S CERTIFICATION: This water well was (1) constructed, (2) reconstructed, or (3) plugged under my jurisdiction and was completed on (mo/day/year) 8-17-88 and this record is true to the best of my knowledge and belief. Kansas

Water Well Contractor's License No. 457 This Water Well Record was completed on (mo/day/yr) 9-12-88

under the business name of United Water Well & Pump by (signature) Paul B. Bunt

INSTRUCTIONS: Use typewriter or ball point pen. PLEASE PRESS FIRMLY and PRINT clearly. Please fill in blanks, underline or circle the correct answers. Send top three copies to Kansas Department of Health and Environment, Bureau of Water Protection, Topeka, Kansas 66620-7320, Telephone: 913-862-9360. Send one to WATER WELL OWNER and retain one for your records.

OFFICE USE ONLY

T

R

EW

SEC.

1/4

1/4

1/4