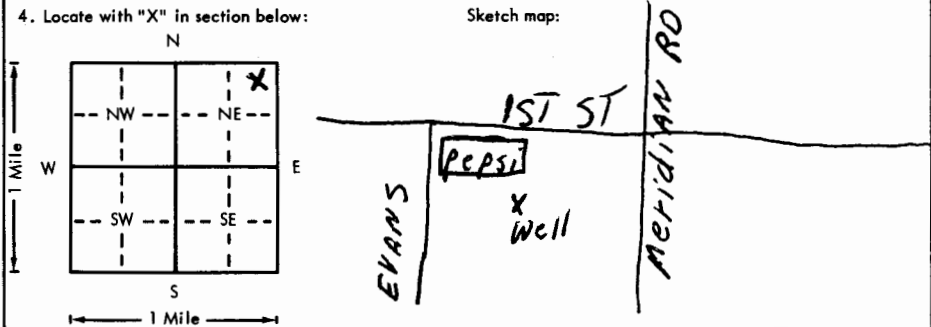


USE TYPEWRITER OR BALL
POINT PEN-PRESS FIRMLY,
PRINT CLEARLY.

WATER WELL RECORD
KSA 82a-1201-1215

Kansas Department of Health and
Environment-Division of Environment
(Water well Contractors)
Topeka, Kansas 66620

1. Location of well: County <u>HARVEY</u> Fraction <u>NE 1/4 NE 1/4 NE 1/4</u> Section number <u>24</u> Township number <u>T 23</u> Range number <u>S R - 1-W</u>	
2. Distance and direction from nearest town or city: Street address of well location if in city: <u>W. 1ST & EVANS</u>	
3. Owner of well: <u>BEN SKENE (PEPSI COIA)</u> R.R. or street: <u>W. 1ST & EVANS</u> City, state, zip code: <u>NEWTON KS</u>	
4. Locate with "X" in section below: Sketch map: 	
5. Type and color of material	
6. Bore hole dia. <u>10</u> in. Completion date <u>6-23-76</u> Well depth <u>65</u> ft.	
7. <input checked="" type="checkbox"/> Cable tool <input checked="" type="checkbox"/> Rotary <input type="checkbox"/> Driven <input type="checkbox"/> Dug <input type="checkbox"/> Hollow rod <input type="checkbox"/> Jetted <input type="checkbox"/> Bored <input type="checkbox"/> Reverse rotary	
8. Use: <input type="checkbox"/> Domestic <input type="checkbox"/> Public supply <input type="checkbox"/> Industry <input checked="" type="checkbox"/> Irrigation <input type="checkbox"/> Air conditioning <input type="checkbox"/> Stock <input checked="" type="checkbox"/> Lawn <input type="checkbox"/> Oil field water <input type="checkbox"/> Other	
9. Casing: Material <u>PVC</u> Height: (Above or below) <u>Surface</u> Threaded <input type="checkbox"/> Welded <input type="checkbox"/> Surface <u>18</u> in. RMP <input checked="" type="checkbox"/> PYC <input type="checkbox"/> Weight <u>12</u> lbs./ft. Dia. <u>5</u> in. to <u>65</u> ft. depth Wall Thickness: inches or Dia. <u>5</u> in. to <u>65</u> ft. depth gage No. <u>200</u>	
10. Screen: Manufacturer's name <u>J & J</u> Type <u>RMP</u> Dia. <u>5</u> Slot/gauze <u>.06</u> Length <u>40</u> Set between <u>25</u> ft. and <u>65</u> ft. Gravel pack? <input checked="" type="checkbox"/> Size range of material <u>1/8-1/4</u>	
11. Static water level: <u>20</u> ft. below land surface Date <u>6-23-76</u> mo./day/yr.	
12. Pumping level below land surfaces: <u>45</u> ft. after <u>1</u> hrs. pumping <u>12</u> g.p.m. <u> </u> ft. after <u> </u> hrs. pumping <u> </u> g.p.m. Estimated maximum yield <u>12</u> g.p.m.	
13. Water sample submitted: <u> </u> mo./day/yr. Yes <input checked="" type="checkbox"/> No <input type="checkbox"/> Date <u> </u>	
14. Well head completion: <u>18</u> inches above grade <input type="checkbox"/> Pitless adapter	
15. Well grouted? <u>YES</u> With: <input checked="" type="checkbox"/> Neat cement <input type="checkbox"/> Bentonite <input type="checkbox"/> Concrete Depth: From <u>0</u> ft. to <u>10</u> ft.	
16. Nearest source of possible contamination: ft. <u>N</u> Direction <u>100</u> Type <u>SEWER</u> Well disinfected upon completion? <input checked="" type="checkbox"/> Yes <input type="checkbox"/> No	
17. Pump: <input checked="" type="checkbox"/> Not installed Manufacturer's name <u> </u> Model number <u> </u> HP <u> </u> Volts <u> </u> Length of drop pipe <u> </u> ft. capacity <u> </u> g.p.m. Type: <input type="checkbox"/> Submersible <input type="checkbox"/> Turbine <input type="checkbox"/> Jet <input type="checkbox"/> Reciprocating <input type="checkbox"/> Centrifugal <input type="checkbox"/> Other	
18. Elevation: Topography: <u> </u> Hill <u> </u> Slope <u> </u> Upland <u> </u> Valley	
19. Remarks: <u>MR SKENE WILL INSTALL 4X4 CMT SLAB ABOVE GRND HE KNOWS THIS IS A REGULATION</u> <u>X BEN SKENE</u>	
20. Water well contractor's certification: This well was drilled under my jurisdiction and this report is true to the best of my knowledge and belief. <u>D. R. Williams</u> <u>211</u> Business name <u> </u> License No. <u> </u> Address <u>4220 W 3RD Newton, KS</u> Signed <u>D. R. Williams</u> Date <u>6-23-76</u> Authorized representative	

23 - 10 24 NE NE NE
T R Sec 1/4 1/4 1/4