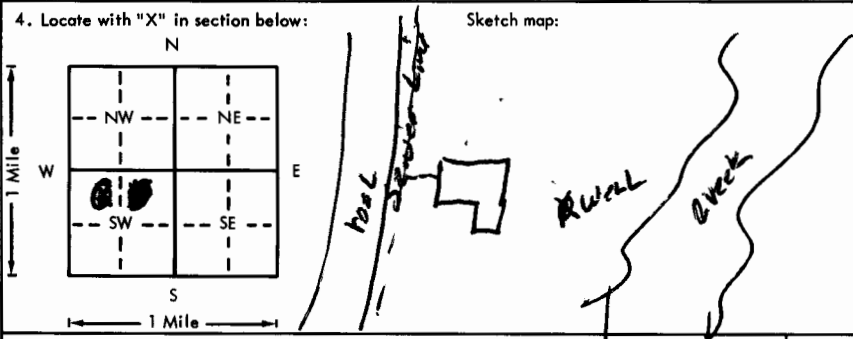


USE TYPEWRITER OR BALL  
POINT PEN-PRESS FIRMLY,  
PRINT CLEARLY.

WATER WELL RECORD  
KSA 82a-1201-1215

Kansas Department of Health and  
Environment-Division of Environment  
(Water well Contractors)  
Topeka, Kansas 66620

#1

1. Location of well:		County <b>HARVEY</b>	Fraction <b>NE 1/4 NW 1/4 SW 1/4</b>	Section number <b>24</b>	Township number <b>T 23 S R 1 E</b>	Range number <b>1 E</b>
2. Distance and direction from nearest town or city: Street address of well location if in city:		<b>Lot #2 - block #3 Royer WEST ADD.</b>		3. Owner of well: R.R. or street: City, state, zip code:		
4. Locate with "X" in section below:		Sketch map:		6. Bore hole dia. <u>11</u> in. Completion date <u>8-5-78</u> Well depth <u>85</u> ft.		
				7. <input checked="" type="checkbox"/> Cable tool <input checked="" type="checkbox"/> Rotary <input type="checkbox"/> Driven <input type="checkbox"/> Dug <input type="checkbox"/> Hollow rod <input type="checkbox"/> Jetted <input type="checkbox"/> Bored <input type="checkbox"/> Reverse rotary		
5. Type and color of material		From		To		8. Use: <input checked="" type="checkbox"/> Domestic <input type="checkbox"/> Public supply <input type="checkbox"/> Industry <input type="checkbox"/> Irrigation <input type="checkbox"/> Air conditioning <input type="checkbox"/> Stock <input type="checkbox"/> Lawn <input type="checkbox"/> Oil field water <input type="checkbox"/> Other
LOAM		0		5		9. Casing: Material <u>plastic</u> Height: Above or below Threaded <input type="checkbox"/> Welded <input type="checkbox"/> Surface <u>36</u> in. RMP <input type="checkbox"/> PVC <input checked="" type="checkbox"/> Weight <u>382</u> lbs./ft. Dia. <u>5</u> in. to <u>23</u> ft. depth Wall Thickness: inches or Dia. <u>5</u> in. to <u>23</u> ft. depth gage No. <u>258</u>
" to Gritty BROWN CLAY		5		10		10. Screen: Manufacturer's name <u>PUMPLE</u> Type <u>PVC</u> Dia. <u>5"</u> Slot/gauze <u>1020</u> Length <u>15'</u> Set between <u>91'</u> ft. and <u>81'</u> ft. <u>22'</u> ft. and <u>17'</u> ft. Gravel pack? <input checked="" type="checkbox"/> Size range of material <u>1/2-1/4</u>
BROWN CLAY		10		17		11. Static water level: <u>6'</u> ft. below land surface Date <u>8-5-78</u> mo./day/yr.
SAND / CLAY mix - sharp		17		19		12. Pumping level below land surfaces: <u>75</u> ft. after <u>2</u> hrs. pumping <u>10</u> g.p.m. <u>75</u> ft. after <u>2</u> hrs. pumping <u>10</u> g.p.m. Estimated maximum yield <u>10/12</u> g.p.m.
GREEN - GRAY shale		19		21		13. Water sample submitted: <u>mo./day/yr.</u> Yes <input checked="" type="checkbox"/> No <input type="checkbox"/> Date <u>8-5-78</u>
DARK SHALE		21		23		14. Well head completion: <input checked="" type="checkbox"/> Pitless adapter <u>inches</u> above grade
HARD LIMB ROCK		23		24		15. Well grouted? <input checked="" type="checkbox"/> With: <input checked="" type="checkbox"/> Neat cement <input type="checkbox"/> Bentonite <input type="checkbox"/> Concrete Depth: From <u>12</u> ft. to <u>0</u> ft.
DARK SHALE		24		49		16. Nearest source of possible contamination: <u>MUD</u> ft. <u>20</u> Direction <u>EAST</u> Type <u>Creek</u> Well disinfected upon completion? <input checked="" type="checkbox"/> Yes <input type="checkbox"/> No
HARD LIMB ROCK		49		51		17. Pump: <input checked="" type="checkbox"/> Not installed Manufacturer's name _____ Model number _____ HP _____ Volts _____ Length of drop pipe _____ ft. capacity _____ g.p.m. Type: <input type="checkbox"/> Submersible <input type="checkbox"/> Turbine <input type="checkbox"/> Jet <input type="checkbox"/> Reciprocating <input type="checkbox"/> Centrifugal <input type="checkbox"/> Other
DARK SHALE		51		93		20. Water well contractor's certification: This well was drilled under my jurisdiction and this report is true to the best of my knowledge and belief. <u>PAUL'S TAIL #125</u> Business name _____ License No. _____ Address <u>Box 26 Heaton, KS</u> Signed <u>Paul Paul</u> Date <u>8/5/78</u> Authorized representative
SEVERAL SMALL FAULTS - 70'-25'						
(Use a second sheet if needed)						
18. Elevation:		19. Remarks:		20. Water well contractor's certification:		
Topography: <input type="checkbox"/> Hill <input type="checkbox"/> Slope <input type="checkbox"/> Upland <input type="checkbox"/> Valley						

23 - 10 24 NE 1/4 24  
Sec 1/4 1/4 1/4 1/4