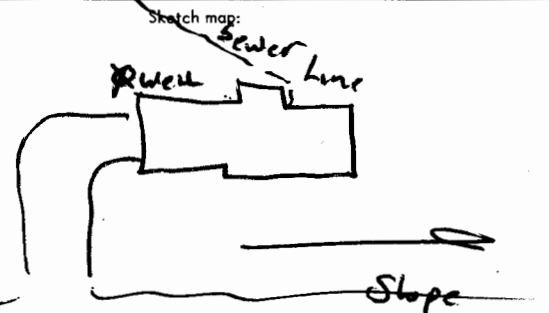


USE TYPEWRITER OR BALL
POINT PEN-PRESS FIRMLY,
PRINT CLEARLY.

WATER WELL RECORD
KSA 82a-1201-1215

Kansas Department of Health and
Environment-Division of Environment
(Water well Contractors)
Topeka, Kansas 66620

1. Location of well:		County HARVEY	Fraction NW 1/4 NW 1/4 SW 1/4	Section number 24	Township number T 23 S R 1	Range number 1
2. Distance and direction from nearest town or city:		3. Owner of well:		Street address of well location if in city:		
Street address of well location if in city:		R.R. or street:		City, state, zip code:		
4. Locate with "X" in section below:		Sketch map:		6. Bore hole dia. 11 in. Completion date 5-1/79		
N W E S 1 Mile				Well depth 48 ft.		
5. Type and color of material		From		To		7. <input checked="" type="checkbox"/> Cable tool <input checked="" type="checkbox"/> Rotary <input type="checkbox"/> Driven <input type="checkbox"/> Dug <input type="checkbox"/> Hollow rod <input type="checkbox"/> Jetted <input type="checkbox"/> Bored <input type="checkbox"/> Reverse rotary
Fill dirt to br clay		0		6		8. Use: <input checked="" type="checkbox"/> Domestic <input type="checkbox"/> Public supply <input type="checkbox"/> Industry <input type="checkbox"/> Irrigation <input type="checkbox"/> Air conditioning <input type="checkbox"/> Stock <input type="checkbox"/> Lawn <input type="checkbox"/> Oil field water <input type="checkbox"/> Other
red / brown clay w/ ALKali		6		10		9. Casing: Material Plastic Height: Above or below Threaded <input type="checkbox"/> Welded <input checked="" type="checkbox"/> Surface 12 in. RMP <input type="checkbox"/> PVC <input checked="" type="checkbox"/> Weight 2.82 lbs./ft. Dia 5 in. to 48 ft. depth Wall Thickness: inches or Dia. <input type="checkbox"/> in. to <input type="checkbox"/> ft. depth gage No. 1250
red brown clay		10		18		10. Screen: Manufacturer's name Pumpco Type PVC Dia. 5 Slot/gauze .020 Length 10' Set between 23 ft. and 33 ft. Gravel pack? <input checked="" type="checkbox"/> Size range of material 1/8-1/4
Light BROWN CLAY		18		22		11. Static water level: 17 ft. below land surface Date 4/12/79
COARSE SAND		22		30		12. Pumping level below land surfaces: 26 ft. after 2 hrs. pumping 18 g.p.m. 26 ft. after 2 hrs. pumping 18 g.p.m. Estimated maximum yield 20 g.p.m.
Green / grey Shale		30		38		13. Water sample submitted: Yes <input checked="" type="checkbox"/> No <input type="checkbox"/> Date 4/12/79
GRAY SHALE		38		42		14. Well head completion: <input checked="" type="checkbox"/> Pitless adapter 12 inches above grade
Wellington Shale		42		48		15. Well grouted? <input checked="" type="checkbox"/> With: <input checked="" type="checkbox"/> Neat cement <input type="checkbox"/> Bentonite <input type="checkbox"/> Concrete Depth: From 0 ft. to 10 ft.
						16. Nearest source of possible contamination: house ft. 35 Direction SE Type Sanitation Well disinfected upon completion? <input checked="" type="checkbox"/> Yes <input type="checkbox"/> No
						17. Pump: Manufacturer's name Dempster Model number MBG-3-19152 1/2 Volt 230 Length of drop pipe 40 ft. capacity 12 g.p.m. Type: <input checked="" type="checkbox"/> Submersible <input type="checkbox"/> Turbine <input type="checkbox"/> Jet <input type="checkbox"/> Reciprocating <input type="checkbox"/> Centrifugal <input type="checkbox"/> Other
						20. Water well contractor's certification: This well was drilled under my jurisdiction and this report is true to the best of my knowledge and belief. Paul's Inc #125 Business name Box 26 Hession License No. Address Paul Bullat Date 5/1/79 Signed Paul Bullat Authorized representative
18. Elevation:		19. Remarks:				
Topography: <input type="checkbox"/> Hill <input type="checkbox"/> Slope <input type="checkbox"/> Upland <input type="checkbox"/> Valley						