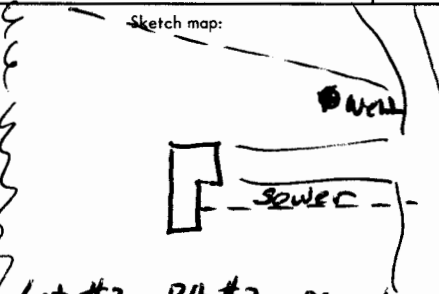


USE TYPEWRITER OR BALL
POINT PEN-PRESS FIRMLY,
PRINT CLEARLY.

WATER WELL RECORD
KSA 82a-1201-1215

Kansas Department of Health and
Environment-Division of Environment
(Water well Contractors)
Topeka, Kansas 66620

1. Location of well:		County HARVEY	Fraction SE 1/4 NW 1/4 NW 1/4	Section number 27	Township number T 23 S R 1	Range number 1 (W)
2. Distance and direction from nearest town or city: Street address of well location if in city:		3/4 mile west of Newton		3. Owner of well: GREG Elder R.R. or street: City, state, zip code: Newton, Kansas		
4. Locate with "X" in section below: N W E S 1 Mile		Sketch map: 		6. Bore hole dia. 11 in. Completion date 12/1/78 Well depth 48 ft.		
5. Type and color of material		From	To	7. <input checked="" type="checkbox"/> Cable tool <input checked="" type="checkbox"/> Rotary <input type="checkbox"/> Driven <input type="checkbox"/> Dug <input type="checkbox"/> Hollow rod <input type="checkbox"/> Jetted <input type="checkbox"/> Bored <input type="checkbox"/> Reverse rotary		
Top soil		0	2	8. Use: <input checked="" type="checkbox"/> Domestic <input type="checkbox"/> Public supply <input type="checkbox"/> Industry <input type="checkbox"/> Irrigation <input type="checkbox"/> Air conditioning <input type="checkbox"/> Stock <input type="checkbox"/> Lawn <input type="checkbox"/> Oil field water <input type="checkbox"/> Other		
DARK BROWN CLAY		2	5	9. Casing: Material PVC Height: Above or below Threaded <input type="checkbox"/> Welded <input checked="" type="checkbox"/> Surface 12 in. RMP <input type="checkbox"/> PVC <input checked="" type="checkbox"/> Weight 2.82 lbs./ft. Dia. 5 in. to 48 ft. depth Wall Thickness: inches or Dia. <input type="checkbox"/> in. to <input type="checkbox"/> ft. depth gage No. 1258		
RED BROWN CLAY - w/ ALKALI		5	14	10. Screen: Manufacturer's name Pumpco Type PVC Dia. 5" Slot/gauze 1/20 Length 15 Set between 22 ft. and 37 ft. Gravel pack? <input checked="" type="checkbox"/> Size range of material 1/8/1/4		
COURSE BROWN + WHITE SAND		14	19	11. Static water level: 17 ft. below land surface Date 12/1/78 mo./day/yr.		
GREY / BROWN CLAY		19	23	12. Pumping level below land surfaces: 27 ft. after 3 hrs. pumping 18 g.p.m. 27 ft. after 3 hrs. pumping 18 g.p.m. Estimated maximum yield 20 g.p.m.		
FINE TO MED BROWN SAND w/ CLAY NODULES		23	34	13. Water sample submitted: No mo./day/yr. Yes <input checked="" type="checkbox"/> No <input type="checkbox"/> Date		
GREEN SHALE		34	36	14. Well head completion: <input checked="" type="checkbox"/> Pitless adapter <input type="checkbox"/> Inches above grade		
MED. BROWN SAND		36	38	15. Well grouted? <input checked="" type="checkbox"/> With: <input checked="" type="checkbox"/> Neat cement <input type="checkbox"/> Bentonite <input type="checkbox"/> Concrete Depth: From 12 ft. to 0 ft.		
GREY to DARK SHALE w/ thin hard layer of white rock - at 39'		38	48	16. Nearest source of possible contamination: ft. 60 Direction So Type Surface Well disinfected upon completion? <input checked="" type="checkbox"/> Yes <input type="checkbox"/> No		
(Use a second sheet if needed)				17. Pump: Manufacturer's name Dempster Model number MBC-352HP 1/2 Volts 220 Length of drop pipe 38 ft. capacity 12 g.p.m. Type: <input checked="" type="checkbox"/> Submersible <input type="checkbox"/> Turbine <input type="checkbox"/> Jet <input type="checkbox"/> Reciprocating <input type="checkbox"/> Centrifugal <input type="checkbox"/> Other		
18. Elevation:		19. Remarks:		20. Water well contractor's certification: This well was drilled under my jurisdiction and this report is true to the best of my knowledge and belief. PAUL'S INC #125 Business name HESSTON, KANSAS License No. Address PAUL B. BENT Signed Paul B. Bent Date 1/2/79 Authorized representative		