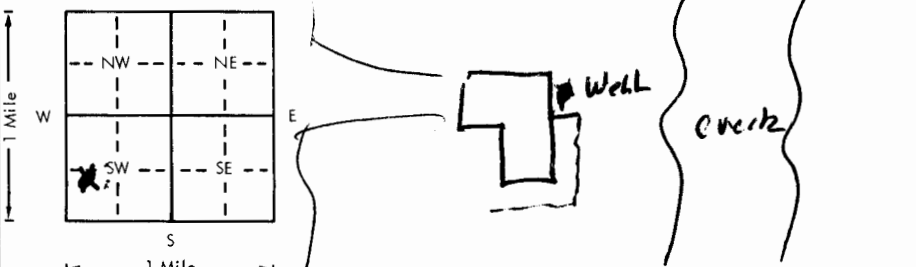


1. Location of well: HARVEY		Fraction NW 1/4 SW 1/4 SW 1/4	Section number 24	Township number T 23	Range number S 1 E 2
2. Distance and direction from nearest town or city: 1 West 1/2 S of Newton - lot #10 Royce West Addition		3. Owner of well: Charles Koehn Jr. RR # Newton, ks			
4. Locate with "X" in section below: 		6. Bore hole dia. 11 in. Completion date Well depth 78 ft. 7/17/78			
5. Type and color of material		7. <input checked="" type="checkbox"/> Cable tool <input checked="" type="checkbox"/> Rotary <input type="checkbox"/> Driven <input type="checkbox"/> Dug <input type="checkbox"/> Hollow rod <input type="checkbox"/> Jetted <input type="checkbox"/> Bored <input type="checkbox"/> Reverse rotary			
8. Use: <input checked="" type="checkbox"/> Domestic <input type="checkbox"/> Public supply <input type="checkbox"/> Industry <input type="checkbox"/> Irrigation <input type="checkbox"/> Air conditioning <input type="checkbox"/> Stock <input type="checkbox"/> Lawn <input type="checkbox"/> Oil field water <input type="checkbox"/> Other		9. Casing: Material plastic Height Above or below Threaded <input type="checkbox"/> Welded <input type="checkbox"/> Surface 18 in. RMP <input type="checkbox"/> PVC <input checked="" type="checkbox"/> Weight 2.52 lbs./ft. Dia. 5 in. to 28 ft. depth <input checked="" type="checkbox"/> All Thickness: inches or Dia. <input type="checkbox"/> in. to <input type="checkbox"/> ft. depth Gauge No. 225			
10. Screen: Manufacturer's name Kern-Tech		11. Static water level: 8 ft. below land surface Date 7/18/78			
12. Pumping level below land surfaces: ft. after 78 hrs. pumping 5 g.p.m. 42 hrs. pumping 5 g.p.m. Estimated maximum yield 5 g.p.m.		13. Water sample submitted: <input checked="" type="checkbox"/> Yes <input checked="" type="checkbox"/> No Date			
14. Well head completion: <input checked="" type="checkbox"/> Pitless adapter 18 inches above grade		15. Well grouted? <input checked="" type="checkbox"/> With: <input checked="" type="checkbox"/> Neat cement <input type="checkbox"/> Bentonite <input type="checkbox"/> Concrete Depth: From 10 ft. to 0 ft.			
16. Nearest source of possible contamination: ft. 25 Direction EAST Type check Well disinfected upon completion? <input checked="" type="checkbox"/> Yes <input type="checkbox"/> No		17. Pump: <input checked="" type="checkbox"/> Not installed Manufacturer's name Model number HP Volts Length of drop pipe ft. capacity g.p.m. Type: <input type="checkbox"/> Submersible <input type="checkbox"/> Turbine <input type="checkbox"/> Jet <input type="checkbox"/> Reciprocating <input type="checkbox"/> Centrifugal <input type="checkbox"/> Other			
18. Elevation:		19. Remarks:			
20. Water well contractor's certification: This well was drilled under my jurisdiction and this report is true to the best of my knowledge and belief. PAUL'S INC #175 Business name License No. Address Box 26 Hesston, Ks Signed Paul Burchard Date 7/18 Authorized representative					