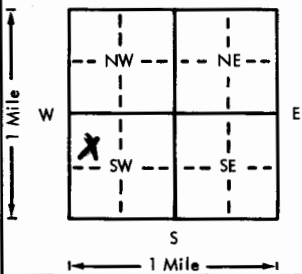


USE TYPEWRITER OR BALL  
POINT PEN-PRESS FIRMLY,  
PRINT CLEARLY.

WATER WELL RECORD  
KSA 82a-1201-1215

Kansas Department of Health and  
Environment-Division of Environment  
(Water well Contractors)  
Topeka, Kansas 66620

1. Location of well:		County: <u>HARVEY</u>	Fraction: <u>SW 1/4 NW 1/4 SW 1/4</u>	Section number: <u>24</u>	Township number: <u>T 23</u>	Range number: <u>S 1 R 1</u>
2. Distance and direction from nearest town or city:				3. Owner of well: <u>Stan Broadhagen</u>		
Street address of well location if in city: <u>Lot 6 Bk 1 Royce addition West</u>				R.R. or street: <u>517 So Poplar</u>		
4. Locate with "X" in section below:				City, state, zip code: <u>Newton KS 67114</u>		
Sketch map:				6. Bore hole dia. <u>11</u> in. Completion date: <u>10/25/77</u>		
				Well depth: <u>75</u> ft.		
5. Type and color of material				7. Cable tool <input checked="" type="checkbox"/> Rotary <input type="checkbox"/> Driven <input type="checkbox"/> Dug		
				<input type="checkbox"/> Hollow rod <input type="checkbox"/> Jetted <input type="checkbox"/> Bored <input type="checkbox"/> Reverse rotary		
				8. Use: <input checked="" type="checkbox"/> Domestic <input type="checkbox"/> Public supply <input type="checkbox"/> Industry		
				<input type="checkbox"/> Irrigation <input type="checkbox"/> Air conditioning <input type="checkbox"/> Stock		
				<input type="checkbox"/> Lawn <input type="checkbox"/> Oil field water <input type="checkbox"/> Other		
				9. Casing: Material <u>PVC</u> Height: <u>Above</u> or below		
				Threaded <input type="checkbox"/> Welded <input checked="" type="checkbox"/> Surface <u>12</u> in.		
				RMP <input type="checkbox"/> PVC <input checked="" type="checkbox"/> Weight <u>2.37</u> lbs./ft.		
				Dia <u>5</u> in. to <u>75</u> ft. depth Wall Thickness: inches or		
				Dia. <u>5</u> in. to <u>75</u> ft. depth gage No. <u>214</u>		
				10. Screen: Manufacturer's name <u>M.P.I.</u>		
				Type <u>PVC</u> Dia. <u>5</u> in.		
				Slot/gauze <u>1/16</u> Length <u>45</u> ft.		
				Set between <u>30</u> ft. and <u>750</u> ft.		
				Gravel pack? <u>yes</u> Size range of material <u>3/8</u>		
				11. Static water level: <u>24</u> ft. below land surface Date <u>10/25/77</u>		
				12. Pumping level below land surfaces:		
				<u>62</u> ft. after <u>3 1/2</u> hrs. pumping <u>10</u> g.p.m.		
				<u>62</u> ft. after <u>3 1/2</u> hrs. pumping <u>10</u> g.p.m.		
				Estimated maximum yield <u>12-15</u> g.p.m.		
				13. Water sample submitted: <u>Yes</u> <input checked="" type="checkbox"/> No <input type="checkbox"/> Date <u>10/25/77</u>		
				14. Well head completion: <u>12</u> inches above grade		
				15. Well grouted? <u>yes</u>		
				With: <input checked="" type="checkbox"/> Neat cement <input type="checkbox"/> Bentonite <input checked="" type="checkbox"/> Concrete		
				Depth: From <u>3</u> ft. to <u>15</u> ft.		
				16. Nearest source of possible contamination: <u>NONE</u>		
				ft. <u>NONE</u> Direction <u>NONE</u>		
				Well disinfected upon completion? <input checked="" type="checkbox"/> Yes <input type="checkbox"/> No		
				17. Pump: <u>Not installed</u>		
				Manufacturer's name <u>Pumpco</u>		
				Model number <u>15510</u> HP <u>1/2</u> Vol <u>220</u>		
				Length of drop pipe <u>66</u> ft. capacity <u>12</u> g.p.m.		
				Type: <input checked="" type="checkbox"/> Submersible <input type="checkbox"/> Turbine		
				<input type="checkbox"/> Jet <input type="checkbox"/> Reciprocating		
				<input type="checkbox"/> Centrifugal <input type="checkbox"/> Other		
18. Elevation:		19. Remarks:		20. Water well contractor's certification:		
Topography:		Customer to pour 4x4x4 slab at top of well to comply with state regulations		This well was drilled under my jurisdiction and this report is true to the best of my knowledge and belief.		
<input type="checkbox"/> Hill				Business name <u>Weninger Drilling</u>		
<input type="checkbox"/> Slope				Address <u>Salisbury KS</u>		
<input type="checkbox"/> Upland				License No. <u>127/78</u>		
<input type="checkbox"/> Valley				Signature <u>Stan Weninger</u>		
				Authorized representative		