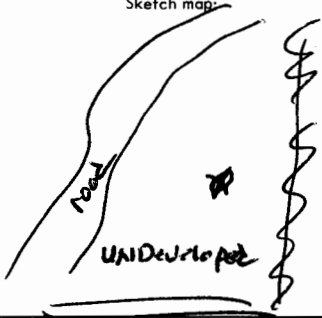


USE TYPEWRITER OR BALL  
POINT PEN-PRESS FIRMLY,  
PRINT CLEARLY.

WATER WELL RECORD  
KSA 82a-1201-1215

Kansas Department of Health and  
Environment-Division of Environment  
(Water well Contractors)  
Topeka, Kansas 66620

1. Location of well: <b>HARVEY</b>	County <b>SE 1/4 NW 1/4 NW 1/4</b>	Section number <b>24</b>	Township number <b>T 23 S R 1 E W</b>	Range number <b>1</b>	
2. Distance and direction from nearest town or city: Street address of well location if in city:		3. Owner of well: R.R. or street: City, state, zip code:			
<b>3/4 mile west of Newton</b> <b>Lot 3 - Blk - 2 - Moorland's</b>		<b>GRBG ELDER (ELDER CONSTR.)</b> <b>NEWTON, KANSAS</b>			
4. Locate with "X" in section below: <div style="text-align: center;">N W ——— NE           E ——— SW — SE S 1 Mile</div>		Sketch map: 			
5. Type and color of material		From	To		
<b>LOAM TO CLAY (BROWN)</b>		<b>0</b>	<b>5</b>		
<b>BROWN CLAY TO RED BROWN ALKALI</b>		<b>5</b>	<b>10</b>		
<b>BROWN ALKALI CLAY TO SANDY BR. CLAY</b>		<b>10</b>	<b>16</b>		
<b>COURSE BROWN SAND</b>		<b>16</b>	<b>19</b>		
<b>RED BROWN CLAY &amp; FINE SAND MIX</b>		<b>19</b>	<b>30</b>		
<b>FINE BROWN SAND w/ CLAY NODULES</b>		<b>30</b>	<b>40</b>		
<b>MED " SAND</b>		<b>40</b>	<b>46</b>		
<b>GREEN SHALE</b>		<b>46</b>	<b>48</b>		
(Use a second sheet if needed)					
18. Elevation:		19. Remarks:			
Topography: Hill _____ Slope _____ Upland _____ Valley _____					
		20. Water well contractor's certification: This well was drilled under my jurisdiction and this report is true to the best of my knowledge and belief. <b>PAUL'S INC #125</b> Business name License No. Address <b>HESSIAN, KANSAS</b> Signed <b>Paul Benoit</b> Date <b>1/2/78</b> Authorized representative			