

County: HARVEY Fraction: NW SW SW Sec. 24 T. 23 S R. 1 W

CORRECTION(S) to WATER WELL COMPLETION RECORD Form WWC-5 (to rectify lacking or incorrect information)

Owner: Harder Construction

If location corrected, was listed as:

Section-Township-Range: 25-23s-1w

Location changed to:

24-23s-1w

Fraction (1/4 calls): _____

Other changes: Initial statements: _____

Changed to: _____

Comments: Domestic well in home, was plotting within HV Co Landfill site.

Verification method: address of well & neighboring wells in Sec 24. HV Co GIS mapper. KGS Interactive Mapper.

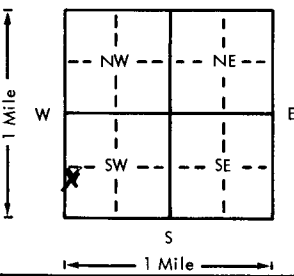
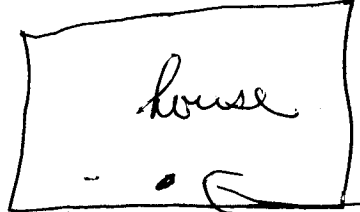
Initials: DLS Date: 01/21/2020

Submitted by: ☒ Kansas Geological Survey, Data Resources Library, 1930 Constant Ave., Lawrence, KS 66047-3724
☐ Kansas Dept. of Health & Environment, Bureau of Water, 1000 SW Jackson, Suite 420, Topeka, KS 66612-1367

USE TYPEWRITER OR BALL
POINT PEN-PRESS FIRMLY,
PRINT CLEARLY.

WATER WELL RECORD
KSA 82a-1201-1215

Kansas Department of Health and
Environment-Division of Environment
(Water well Contractors)
Topeka, Kansas 66620

1. Location of well:	County <u>HARVEY</u>	Fraction <u>NW 1/4 SW 1/4 SW 1/4</u>	Section number <u>25</u>	Township number <u>T 23 S</u>	Range number <u>R 1 W</u>
Distance and direction from nearest town or city: <u>1 mile West Milton, KS</u>		3. Owner of well: <u>Harder Const</u>			
Street address of well location if in city: <u>Lot #9 Royal Addition West</u>		R.R. or street: <u>Ex 126</u>			
		City, state, zip code: <u>Peabody, KS 66866</u>			
4. Locate with "X" in section below:		Sketch map:		6. Bore hole dia. <u>11</u> in. Completion date <u>8/15/79</u>	
				Well depth <u>80</u> ft.	
5. Type and color of material		From	To	7. Cable tool <input checked="" type="checkbox"/> Rotary <input type="checkbox"/> Driven <input type="checkbox"/> Dug	
<u>Top soil</u>		<u>0</u>	<u>2</u>	<input type="checkbox"/> Hollow rod <input type="checkbox"/> Jetted <input type="checkbox"/> Bored <input type="checkbox"/> Reverse rotary	
<u>fine sand</u>		<u>2</u>	<u>12</u>	8. Use: <input checked="" type="checkbox"/> Domestic <input type="checkbox"/> Public supply <input type="checkbox"/> Industry	
<u>black shale</u>		<u>12</u>	<u>80</u>	<input type="checkbox"/> Irrigation <input type="checkbox"/> Air conditioning <input type="checkbox"/> Stock	
				<input type="checkbox"/> Lawn <input type="checkbox"/> Oil field water <input type="checkbox"/> Other	
				9. Casing: Material <u>Steel</u> Height: Above or below	
				Threaded <input type="checkbox"/> Welded <input checked="" type="checkbox"/> Surface <u>12</u> in.	
				RMP <input checked="" type="checkbox"/> PVC <input type="checkbox"/> Weight <u>1.50</u> lbs./ft.	
				Dia <u>5</u> in. to <u>80</u> ft. depth Wall Thickness: inches or	
				Dia. <u>5</u> in. to <u>80</u> ft. depth gage No. <u>1200</u>	
				10. Screen: Manufacturer's name <u>CER-MAC</u>	
				Type <u>200</u> Dia. <u>5</u> in.	
				Slot gauge <u>1/16</u> Length <u>50</u> ft.	
				Set between <u>30</u> ft. and <u>80</u> ft.	
				Gravel pack? <u>yes</u> Size range of material <u>18-30</u>	
				11. Static water level: <u>15</u> ft. below land surface Date <u>8/15/79</u>	
				12. Pumping level below land surfaces:	
				<u>35</u> ft. after <u>12</u> hrs. pumping <u>8</u> g.p.m.	
				<u> </u> ft. after <u> </u> hrs. pumping <u> </u> g.p.m.	
				Estimated maximum yield <u>10-14</u> g.p.m.	
				13. Water sample submitted: <u> </u> mo./day/yr.	
				<u> </u> Yes <input checked="" type="checkbox"/> No <u> </u> Date <u> </u>	
				14. Well head completion:	
				<u> </u> Pitless adapter <u>12</u> Inches above grade	
				15. Well grouted? <u>yes</u>	
				With: <u> </u> Neat cement <u> </u> Bentonite <input checked="" type="checkbox"/> Concrete	
				Depth: From <u>6</u> ft. to <u>16</u> ft.	
				16. Nearest source of possible contamination: <u>main sewer</u>	
				ft. <u>80</u> Direction <u>E</u> Type <u>sewer</u>	
				Well disinfected upon completion? <input checked="" type="checkbox"/> Yes <u> </u> No	
				17. Pump: <input checked="" type="checkbox"/> Not installed	
				Manufacturer's name <u> </u>	
				Model number <u> </u> HP <u> </u> Volts <u> </u>	
				Length of drop pipe <u> </u> ft. capacity <u> </u> g.p.m.	
				Type:	
				<u> </u> Submersible <u> </u> Turbine	
				<u> </u> Jet <u> </u> Reciprocating	
				<u> </u> Centrifugal <u> </u> Other	
18. Elevation:		20. Water well contractor's certification:			
Topography:		This well was drilled under my jurisdiction and this report			
<u> </u> Hill		is true to the best of my knowledge and belief.			
<input checked="" type="checkbox"/> Slope		<u>Wenger Pump</u> 318			
<input checked="" type="checkbox"/> Upland		Business name <u>Caprich KS</u> License No. <u> </u>			
<u> </u> Valley		Address <u> </u>			
		Signed <u>Wenger</u> 8/15/79 Date <u> </u>			
		Authorized representative			

Forward the white, blue and pink copies to the Department of Health and Environment

Form WWC-5