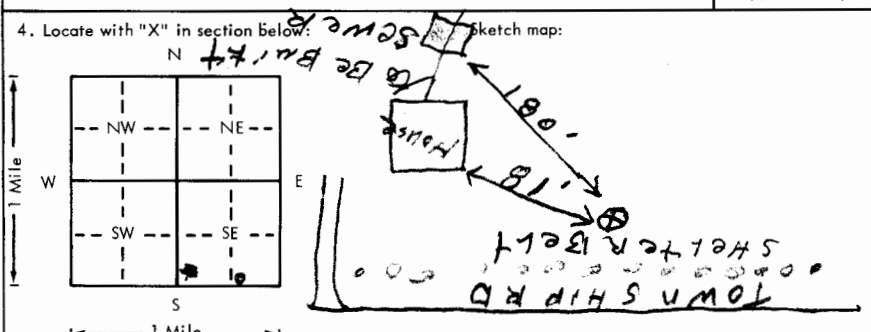


USE TYPEWRITER OR BALL
POINT PEN-PRESS FIRMLY,
PRINT CLEARLY.

WATER WELL RECORD
KSA 82a-1201-1215

Kansas Department of Health and
Environment-Division of Environment
(Water well Contractors)
Topeka, Kansas 66620

1. Location of well: County <u>HARVEY</u> Fraction <u>SW 1/4 SE 1/4 SE 1/4</u> Section number <u>26</u> Township number <u>T 23 S</u> Range number <u>R 1 E</u>	
2. Distance and direction from nearest town or city: <u>2 W. 2 mi. from Newton</u>	
3. Owner of well: <u>JIM WELLY</u> R.R. or street: <u>RT 1</u> City, state, zip code: <u>Newton, K 67114</u>	
4. Locate with "X" in section below: 	
5. Type and color of material	
6. Bore hole dia. <u>10</u> in. Completion date <u>4-15-78</u> Well depth <u>102</u> ft.	
7. <input checked="" type="checkbox"/> Cable tool <input type="checkbox"/> Rotary <input type="checkbox"/> Driven <input type="checkbox"/> Dug <input type="checkbox"/> Hollow rod <input type="checkbox"/> Jetted <input type="checkbox"/> Bored <input type="checkbox"/> Reverse rotary	
8. Use: <input checked="" type="checkbox"/> Domestic <input type="checkbox"/> Public supply <input type="checkbox"/> Industry <input type="checkbox"/> Irrigation <input type="checkbox"/> Air conditioning <input checked="" type="checkbox"/> Stock <input type="checkbox"/> Lawn <input type="checkbox"/> Oil field water <input type="checkbox"/> Other	
9. Casing: Material <u>PVC</u> Height: Above or below Threaded <input type="checkbox"/> Welded <input checked="" type="checkbox"/> Surface <u>20</u> in. RMP <u>PVC</u> Weight <u>10</u> lbs./ft. Dia. <u>5</u> in. to <u>102</u> ft. depth Wall Thickness: inches or Dia. <u>5</u> in. to <u>102</u> ft. depth gage No. <u>250</u>	
10. Screen: Manufacturer's name <u>M.F.L.</u> Type <u>P.V.C.</u> Dia. <u>5"</u> Slot/gauze <u>25/1000</u> Length <u>10</u> Set between <u>92</u> ft. and <u>102</u> ft. <u>92</u> ft. and <u>102</u> ft. Gravel pack? <input checked="" type="checkbox"/> Size range of material <u>5/8</u>	
11. Static water level: <u>18</u> ft. below land surface Date <u>4-15-78</u> mo./day/yr.	
12. Pumping level below land surfaces: ____ ft. after ____ hrs. pumping ____ g.p.m. ____ ft. after ____ hrs. pumping ____ g.p.m. Estimated maximum yield <u>6</u> g.p.m.	
13. Water sample submitted: <u>P.V.C. CAP</u> <input checked="" type="checkbox"/> Yes <input type="checkbox"/> No Date <u>4-14-78</u> mo./day/yr.	
14. Well head completion: <input type="checkbox"/> Pitless adapter <u>20</u> inches above grade	
15. Well grouted? <u>YES</u> With: <input checked="" type="checkbox"/> Neat cement <input type="checkbox"/> Bentonite <input type="checkbox"/> Concrete Depth: From <u>3</u> ft. to <u>13</u> ft.	
16. Nearest source of possible contamination: ft. <u>100</u> Direction <u>NO</u> Type <u>Lagoon</u> Well disinfected upon completion? <input checked="" type="checkbox"/> Yes <input type="checkbox"/> No	
17. Pump: <input checked="" type="checkbox"/> Not installed Manufacturer's name _____ Model number _____ HP _____ Volts _____ Length of drop pipe _____ ft. capacity _____ g.p.m. Type: <input type="checkbox"/> Submersible <input type="checkbox"/> Turbine <input type="checkbox"/> Jet <input type="checkbox"/> Reciprocating <input type="checkbox"/> Centrifugal <input type="checkbox"/> Other	
18. Elevation: _____	
19. Remarks: <u>Jim Welly</u> <u>Jim agrees to</u> <u>install a concrete slab 4x4x4</u> <u>slab slope away from casing to</u> <u>control a mobile pitless well</u> <u>seal cap.</u>	
20. Water well contractor's certification: This well was drilled under my jurisdiction and this report is true to the best of my knowledge and belief. <u>PREWITT CONSTRUCTION CO. 353</u> Business name _____ License No. _____ Address <u>BOX 144</u> Signed <u>Justin C. Prewitt</u> Date <u>4-15-78</u> Authorized representative	