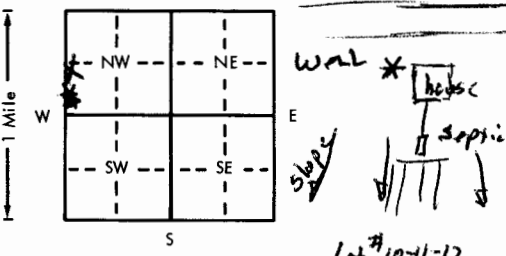


USE TYPEWRITER OR BALL
POINT PEN-PRESS FIRMLY,
PRINT CLEARLY.

WATER WELL RECORD
KSA 82a-1201-1215

Kansas Department of Health and
Environment-Division of Environment
(Water well Contractors)
Topeka, Kansas 66620

1. Location of well:		County HARVEY	Fraction (See Legal Desc) NW 1/4 SW 1/4 NW 1/4	Section number 29	Township number T 23	Range number S R 1 EW
2. Distance and direction from nearest town or city: 2 1/2 EAST of HALSTEAD			3. Owner of well: Wm. Brandt R.R. or street: R.R. #1 City, state, zip code: HALSTEAD KANSAS 67056			
4. Locate with "X" in section below:		Sketch map:		6. Bore hole dia. 11 in. Completion date 11/13/75 Well depth 105 ft.		
				7. Cable tool <input checked="" type="checkbox"/> Rotary <input type="checkbox"/> Driven <input type="checkbox"/> Dug Hollow rod <input type="checkbox"/> Jetted <input type="checkbox"/> Bored <input type="checkbox"/> Reverse rotary		
5. Type and color of material		From To		8. Use: <input checked="" type="checkbox"/> Domestic <input type="checkbox"/> Public supply <input type="checkbox"/> Industry <input type="checkbox"/> Irrigation <input type="checkbox"/> Air conditioning <input type="checkbox"/> Stock <input type="checkbox"/> Lawn <input type="checkbox"/> Oil field water <input type="checkbox"/> Other		
dune sand (loam)		0 5		9. Casing: Material PVC Height: Above or below Threaded <input type="checkbox"/> Welded <input checked="" type="checkbox"/> Surface 2 1/2" in. RMP <input type="checkbox"/> PVC <input checked="" type="checkbox"/> Weight <input type="checkbox"/> lbs./ft. Dia. 5 in. to 105 ft. depth Wall Thickness: inches or Dia. <input type="checkbox"/> in. to <input type="checkbox"/> ft. depth gage No. 265		
SANDY CLAY		5 10		10. Screen: Manufacturer's name Geotek own slot Type PVC Dia. 5" Slot/gauze .064 Length 20' Set between 85 ft. and 105 ft. ft. and <input type="checkbox"/> ft. Gravel pack? <input checked="" type="checkbox"/> Size range of material 1/2-1/4		
Red to GREY CLAY		10 15		11. Static water level: top of casing mo./day/yr. 33' ft. below surface Date 11/13/75		
GREY CLAY		15 23		12. Pumping level below top of casing 40 ft. after 1 hrs. pumping 20 g.p.m. ft. after <input type="checkbox"/> hrs. pumping <input type="checkbox"/> g.p.m. Estimated maximum yield 150 g.p.m.		
" " to LIGHT BROWN		23 25		13. Water sample submitted: <input type="checkbox"/> Yes <input checked="" type="checkbox"/> No Date <input type="checkbox"/>		
Light BROWN CLAY		25 40		14. Well head completion: UNKNOWN <input type="checkbox"/> Pitless adapter <input type="checkbox"/> inches above grade		
" " to GREY		40 42		15. Well grouted? <input checked="" type="checkbox"/> With: <input checked="" type="checkbox"/> Neat cement <input type="checkbox"/> Bentonite <input type="checkbox"/> Concrete Depth: From 10 ft. to 0 ft.		
GREY CLAY		42 48		16. Nearest source of possible contamination: ft. <input type="checkbox"/> Direction EAST Type Septic tank Well disinfected upon completion? <input checked="" type="checkbox"/> Yes <input type="checkbox"/> No		
RED BROWN CLAY		48 60		17. Pump: <input checked="" type="checkbox"/> Not installed Manufacturer's name <input type="checkbox"/> Model number <input type="checkbox"/> HP <input type="checkbox"/> Volts <input type="checkbox"/> Length of drop pipe <input type="checkbox"/> ft. capacity <input type="checkbox"/> g.p.m. Type: <input type="checkbox"/> Submersible <input type="checkbox"/> Turbine <input type="checkbox"/> Jet <input type="checkbox"/> Reciprocating <input type="checkbox"/> Centrifugal <input type="checkbox"/> Other		
SANDY BROWN CLAY		60 72		18. Elevation:		
brown-red CLAY		72 75		19. Remarks:		
Light brown CLAY		75 88		20. Water well contractor's certification: This well was drilled under my jurisdiction and this report is true to the best of my knowledge and belief. PAUL'S INC #175 Business name Box 26 Hesston, KS License No. <input type="checkbox"/> Signed Paul Brandt Date 11/13/75 Authorized representative		
SANDY CLAY		88 90				
COMPACTED SAND (Eggs)		90 105				
GREY CLAY		105 107				
(Use a second sheet if needed)						
Topography: <input type="checkbox"/> Hill <input type="checkbox"/> Slope <input type="checkbox"/> Upland <input type="checkbox"/> Valley						