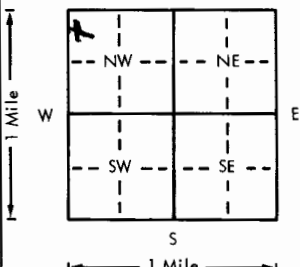


USE TYPEWRITER OR BALL
POINT PEN-PRESS FIRMLY,
PRINT CLEARLY.

WATER WELL RECORD
KSA 82a-1201-1215

Kansas Department of Health and
Environment-Division of Environment
(Water well Contractors)
Topeka, Kansas 66620

1. Location of well: <u>Harvey</u>		County: <u>Harvey</u>	Fraction: <u>NW 1/4 NW 1/4 NW 1/4</u>	Section number: <u>31</u>	Township number: <u>T 23</u>	Range number: <u>S 1 R 1 E 1</u>
2. Distance and direction from nearest town or city: <u>1 East of Halstead and 1 1/4 South of.</u>		3. Owner of well: <u>C. O. Krauss</u> R.R. or street: <u>P.O. Box 269</u> City, state, zip code: <u>Halstead, Kansas</u>				
4. Locate with "X" in section below: 		Sketch map: <u>Highway 50 on the East side of the road. Halstead, Kansas</u>				6. Bore hole dia. <u>11</u> in. Completion date <u>9-7-76</u> Well depth <u>105</u> ft.
5. Type and color of material		From	To	7. <input checked="" type="checkbox"/> Cable tool <input checked="" type="checkbox"/> Rotary <input type="checkbox"/> Driven <input type="checkbox"/> Dug <input type="checkbox"/> Hollow rod <input type="checkbox"/> Jetted <input type="checkbox"/> Bored <input type="checkbox"/> Reverse rotary		
<u>Topsoil</u>		<u>0</u>	<u>2</u>	8. Use: <input checked="" type="checkbox"/> Domestic <input type="checkbox"/> Public supply <input type="checkbox"/> Industry <input type="checkbox"/> Irrigation <input type="checkbox"/> Air conditioning <input type="checkbox"/> Stock <input type="checkbox"/> Lawn <input type="checkbox"/> Oil field water <input type="checkbox"/> Other		
<u>Clay</u>		<u>2</u>	<u>49</u>	9. Casing: Material <u>STYRENE</u> Height: Above or below Threaded <input type="checkbox"/> Welded <input checked="" type="checkbox"/> Surface <u>12</u> in. RMP <input checked="" type="checkbox"/> PVC <input type="checkbox"/> Weight <u>105</u> lbs./ft. Dia. <u>5</u> in. to <u>115</u> ft. depth Wall Thickness: inches or Dia. <u>5</u> in. to <u>115</u> ft. depth gage No. <u>1200</u>		
<u>Fine Sand</u>		<u>49</u>	<u>70</u>	10. Screen: Manufacturer's name <u>SUNFLOWER PLASTIC</u> Type <u>STYRENE</u> Dia. <u>5"</u> Slot gauze <u>100</u> Length <u>20</u> ft. Set between <u>85</u> ft. and <u>105</u> ft. Gravel pack? <u>YES</u> Size range of material <u>1/4 - 1/8"</u>		
<u>Medium Sand</u>		<u>70</u>	<u>78</u>	11. Static water level: <u>30</u> ft. below land surface Date <u>9-7-76</u>		
<u>Clay</u>		<u>78</u>	<u>85</u>	12. Pumping level below land surfaces: ____ ft. after ____ hrs. pumping ____ g.p.m. ____ ft. after ____ hrs. pumping ____ g.p.m. Estimated maximum yield ____ g.p.m.		
<u>Medium Sand</u>		<u>85</u>	<u>105</u>	13. Water sample submitted: ____ mo./day/yr. Yes ____ No ____ Date ____		
				14. Well head completion: <input checked="" type="checkbox"/> Pitless adapter <u>12</u> inches above grade		
				15. Well grouted? <u>YES</u> With: ____ Neat cement ____ Bentonite <input checked="" type="checkbox"/> Concrete Depth: From <u>40</u> ft. to <u>14</u> ft.		
				16. Nearest source of possible contamination: ft. <u>100</u> Direction <u>NW</u> Type <u>Septic Tank</u> Well disinfected upon completion? <input checked="" type="checkbox"/> Yes ____ No		
				17. Pump: <u>Not installed</u> Manufacturer's name <u>Sta-Rite</u> Model number <u>20PDC25</u> HP <u>3/4</u> Volts <u>230</u> Length of drop pipe <u>90</u> ft. capacity <u>20</u> g.p.m. Type: <input checked="" type="checkbox"/> Submersible <input type="checkbox"/> Turbine <input type="checkbox"/> Jet <input type="checkbox"/> Reciprocating <input type="checkbox"/> Centrifugal <input type="checkbox"/> Other		
18. Elevation:		19. Remarks:		20. Water well contractor's certification: This well was drilled under my jurisdiction and this report is true to the best of my knowledge and belief. <u>HARD WELL PUMP 236</u> Business name <u>WICHITA, KANSAS</u> License No. ____ Address <u>WICHITA, KANSAS</u> Signed <u>M. Arnold</u> Date <u>9-17-76</u> Authorized representative		