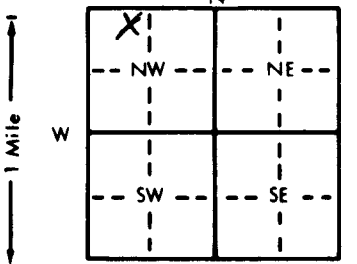


1 LOCATION OF WATER WELL: County: <u>Harvey</u> Distance and direction from nearest town or city street address of well if located within city? <u>2 mi N, 1 1/4 E of Halstead - 10607 W 1st</u>		Fraction <u>NE 1/4 NW 1/4 NW 1/4</u>	Section Number <u>19</u>	Township Number <u>T 23 S</u>	Range Number <u>R 1 EW</u>
2 WATER WELL OWNER: RR#, St. Address, Box # : City, State, ZIP Code : <u>Don Seiler</u> <u>10607 W 1st</u> <u>Halstead, KS 67056</u>		Board of Agriculture, Division of Water Resources Application Number:			
3 LOCATE WELL'S LOCATION WITH AN "X" IN SECTION BOX: 		4 DEPTH OF COMPLETED WELL: <u>118</u> ft. ELEVATION: Depth(s) Groundwater Encountered 1. _____ ft. 2. _____ ft. 3. _____ ft. WELL'S STATIC WATER LEVEL <u>36</u> ft. below land surface measured on mo/day/yr <u>1-12-00</u> Pump test data: Well water was <u>49</u> ft. after <u>2</u> hours pumping <u>25</u> gpm Est. Yield _____ gpm: Well water was _____ ft. after _____ hours pumping _____ gpm Bore Hole Diameter <u>8</u> in. to <u>123</u> ft., and _____ in. to _____ ft. WELL WATER TO BE USED AS: ☒ 1 Domestic ☐ 3 Feedlot ☐ 6 Oil field water supply ☐ 9 Dewatering ☐ 12 Other (Specify below) ☐ 2 Irrigation ☐ 4 Industrial ☐ 7 Lawn and garden only ☐ 10 Monitoring well Was a chemical/bacteriological sample submitted to Department? Yes _____ No ☒ If yes, mo/day/yr sample was submitted Water Well Disinfected? Yes ☒ No			
5 TYPE OF BLANK CASING USED: 1 Steel ☐ 3 RMP (SR) ☐ 5 Wrought iron ☐ 8 Concrete tile ☐ ☒ 2 PVC ☐ 4 ABS ☐ 6 Asbestos-Cement ☐ 9 Other (specify below) _____ Blank casing diameter <u>5</u> in. to <u>108</u> ft. Dia. _____ in. to _____ ft. Dia. _____ in. to _____ ft. Casing height above land surface <u>12</u> in., weight <u>2.29</u> lbs./ft. Wall thickness or gauge No. <u>160</u> TYPE OF SCREEN OR PERFORATION MATERIAL: 1 Steel ☐ 3 Stainless steel ☐ 5 Fiberglass ☐ 8 RMP (SR) ☐ 2 Brass ☐ 4 Galvanized steel ☐ 6 Concrete tile ☐ 9 ABS ☐ SCREEN OR PERFORATION OPENINGS ARE: 1 Continuous slot ☐ 3 Mill slot ☐ 5 Gauzed wrapped ☐ 8 Saw cut ☒ 11 None (open hole) 2 Louvered shutter ☐ 4 Key punched ☐ 6 Wire wrapped ☐ 9 Drilled holes ☐ 7 Torch cut ☐ 10 Other (specify) _____ SCREEN-PERFORATED INTERVALS: From <u>108</u> ft. to <u>118</u> ft., From _____ ft. to _____ ft. From _____ ft. to _____ ft., From _____ ft. to _____ ft. GRAVEL PACK INTERVALS: From <u>23</u> ft. to <u>80</u> ft., From _____ ft. to _____ ft. From <u>85</u> ft. to <u>123</u> ft., From _____ ft. to _____ ft.		CASING JOINTS: Glued ☒ Clamped _____ Welded _____ Threaded _____			
6 GROUT MATERIAL: 1 Neat cement ☐ 2 Cement grout ☐ 3 Bentonite ☒ 4 Other _____ Grout Intervals: From <u>3</u> ft. to <u>23</u> ft., From <u>80</u> ft. to <u>85</u> ft., From _____ ft. to _____ ft. What is the nearest source of possible contamination: ☒ 1 Septic tank ☐ 4 Lateral lines ☐ 7 Pit privy ☐ 10 Livestock pens ☐ 14 Abandoned water well ☐ 2 Sewer lines ☐ 5 Cess pool ☐ 8 Sewage lagoon ☐ 11 Fuel storage ☐ 15 Oil well/Gas well ☐ 3 Watertight sewer lines ☐ 6 Seepage pit ☐ 9 Feedyard ☐ 12 Fertilizer storage ☐ 16 Other (specify below) _____ 13 Insecticide storage _____ Direction from well? <u>NW</u> How many feet? <u>75</u>					
FROM TO LITHOLOGIC LOG		FROM TO PLUGGING INTERVALS			
0	6	Br clay			
6	12	M-C Sand			
12	17	Br clay			
17	19	M Sand			
19	71	Br + Gr Clay			
71	72	M-C Sand			
72	106	Br + Gr Clay - Rocky			
106	118	M-C Sand			
118	123	Shale			
7 CONTRACTOR'S OR LANDOWNER'S CERTIFICATION: This water well was ☒ (1) constructed, (2) reconstructed, or (3) plugged under my jurisdiction and was completed on (mo/day/year) <u>1-12-00</u> and this record is true to the best of my knowledge and belief. Kansas Water Well Contractor's License No. <u>447</u> This Water Well Record was completed on (mo/day/yr) <u>1-17-00</u> under the business name of <u>Miller Drilling</u> by (signature) <u>E. Miller</u>					
INSTRUCTIONS: Use typewriter or ball point pen. PLEASE PRESS FIRMLY and PRINT clearly. Please fill in blanks, underline or circle the correct answers. Send top three copies to Kansas Department of Health and Environment, Bureau of Water, Topeka, Kansas 66620-0001. Telephone: 913-296-5545. Send one to WATER WELL OWNER and retain one for your records.					