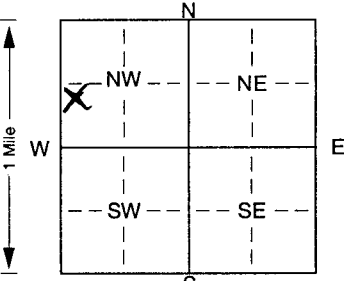


1 LOCATION OF WATER WELL: Fraction NW 1/4 SW 1/4 NW 1/4 Section Number 29 Township Number T 23 S Range Number R 1 E  
 County: Harvey

Distance and direction from nearest town or city street address of well if located within city?  
2 mi E, 3/4 N of Halstead

2 WATER WELL OWNER: Weldon Koehn  
 RR#, St. Address, Box #: 1424 S Mission Rd Board of Agriculture, Division of Water Resources  
 City, State, ZIP Code: Halstead, KS 67056 Application Number:

3 LOCATE WELL'S LOCATION WITH AN "X" IN SECTION BOX:  
  
 4 DEPTH OF COMPLETED WELL: 102 ft. ELEVATION:  
 Depth(s) Groundwater Encountered 1. 1 ft. 2. 1 ft. 3. 1 ft.  
 WELL'S STATIC WATER LEVEL: 55 ft. below land surface measured on mo/day/yr 6-26-01  
 Pump test data: Well water was 60 ft. after 12 hours pumping 20 gpm  
 Est. Yield 20 gpm: Well water was 60 ft. after 12 hours pumping 20 gpm  
 Bore Hole Diameter: 8 in. to 10.5 ft., and 10.5 in. to 10.5 ft.  
 WELL WATER TO BE USED AS: 5 Public water supply 8 Air conditioning 11 Injection well  
 Domestic 3 Feedlot 6 Oil field water supply 9 Dewatering 12 Other (Specify below)  
 2 Irrigation 4 Industrial 7 Domestic (lawn & garden) 10 Monitoring well  
 Was a chemical/bacteriological sample submitted to Department? Yes. X No. X; If yes, mo/day/yr sample was submitted  
 Water Well Disinfected? Yes X No

5 TYPE OF BLANK CASING USED:  
 1 Steel 3 RMP (SR) 5 Wrought iron 8 Concrete tile CASING JOINTS: Glued X Clamped  
 PVC 4 ABS 7 Fiberglass 9 Other (specify below) Welded  
 Blank casing diameter 5 in. to 92 ft., Dia 92 in. to 92 ft., Dia 92 in. to 92 ft.  
 Casing height above land surface 12 in., weight 2.29 lbs./ft. Wall thickness or gauge No. 160  
 TYPE OF SCREEN OR PERFORATION MATERIAL:  
 1 Steel 3 Stainless steel 5 Fiberglass  PVC 10 Asbestos-cement  
 2 Brass 4 Galvanized steel 6 Concrete tile 8 RMP (SR) 11 Other (specify)  
 9 ABS 12 None used (open hole)  
 SCREEN OR PERFORATION OPENINGS ARE:  
 1 Continuous slot 3 Mill slot 5 Gauzed wrapped  Saw cut 11 None (open hole)  
 2 Louvered shutter 4 Key punched 6 Wire wrapped 9 Drilled holes  
 7 Torch cut 10 Other (specify)  
 SCREEN-PERFORATED INTERVALS: From 92 ft. to 102 ft., From 92 ft. to 102 ft.  
 GRAVEL PACK INTERVALS: From 23 ft. to 70 ft., From 23 ft. to 70 ft.  
 From 75 ft. to 105 ft., From 75 ft. to 105 ft.

6 GROUT MATERIAL: 1 Neat cement 2 Cement grout  Bentonite 4 Other  
 Grout Intervals: From 3 ft. to 23 ft., From 70 ft. to 75 ft.  
 What is the nearest source of possible contamination:  
 1 Septic tank 4 Lateral lines 7 Pit privy 10 Livestock pens 14 Abandoned water well  
 2 Sewer lines 5 Cess pool 8 Sewage lagoon 11 Fuel storage 15 Oil well/Gas well  
 3 Watertight sewer lines 6 Seepage pit 9 Feedyard 12 Fertilizer storage  Other (specify below)  
 .... open field ...  
 Direction from well? How many feet?

FROM	TO	LITHOLOGIC LOG	FROM	TO	PLUGGING INTERVALS
0	50	Br Clay			
50	80	Br + Gr Clay			
80	83	F Sand			
83	90	Br Clay			
90	105	Sand + Sm Gravel			

7 CONTRACTOR'S OR LANDOWNER'S CERTIFICATION: This water well was  constructed, (2) reconstructed, or (3) plugged under my jurisdiction and was completed on (mo/day/year) 6-26-01 and this record is true to the best of my knowledge and belief. Kansas Water Well Contractor's Licence No. 447 This Water Well Record was completed on (mo/day/yr) 7-14-01  
 under the business name of Miller Drilling by (signature) E Miller