


1] LOCATION OF WATER WELL:	Fraction	Section Number	Township Number	Range Number
County: <i>Harvey</i>	<i>Se</i> $\frac{1}{4}$ <i>NW</i> $\frac{1}{4}$ <i>NW</i> $\frac{1}{4}$	<i>24</i>	T <i>23</i> S	R <i>1</i> E <i>MP</i>

Distance and direction from nearest town or city street address of well if located within city?
In City Newton 403 Mockingbird Ln. In Hidden Acres

2] WATER WELL OWNER: Matt & Beth Smith ✓
RR#, St. Address, Box # : 403 Mockingbird Ln.
City, State, ZIP Code : Newton, KS. 67114

3	LOCATE WELL'S LOCATION WITH AN "X" IN SECTION BOX:	4	DEPTH OF COMPLETED WELL: <u>76</u> ft. ELEVATION: <u>65</u> Depth(s) Groundwater Encountered <u>12</u> ft. 1. <u>25</u> ft. 2. <u>65</u> ft. 3. <u>8</u> ft. 4. <u>13</u> ft. 5. <u>21</u> ft.
---	--	---	---

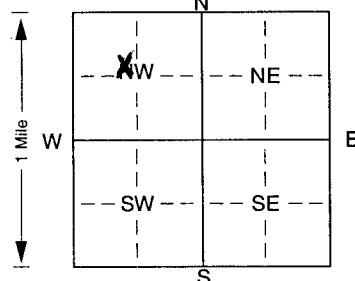

WELL'S STATIC WATER LEVEL... 1.2 ... ft. below land surface measured on mo/day/yr ... 1-1.5 ...

Pump test data: Well water was ... ft. after ... hours pumping ... gpm

Est. Yield 15-20 gpm: Well water was ... ft. after ... hours pumping ... gpm

Bore Hole Diameter... 9 ... in. to ... 3.5 ... ft. and ... 7.5 ... in. to ... 70 ... ft.

WELL WATER TO BE USED AS:

5 Public water supply	8 Air conditioning	11 Injection well		
1 Domestic	3 Feedlot	6 Oil field water supply	9 Dewatering	12 Other (Specify below)
2 Irrigation	4 Industrial	7 Domestic (lawn & garden)	10 Monitoring well	

Was a chemical/bacteriological sample submitted to Department? Yes. No. ☒ ; If yes, mo/day/yr sample was submitted

Water Well Disinfected? Yes ☒ No

5 TYPE OF BLANK CASING USED:	5 Wrought iron	8 Concrete tile	CASING JOINTS: Glued. <input checked="" type="checkbox"/> . . . Clamped.
1 Steel	3 RMP (SR)	6 Asbestos-Cement	9 Other (specify below) Welded.
2 PVC	4 ABS	7 Fiberglass	Threaded.

Blank casing diameter . . . 5 . . . in. to . . . 23 . . . ft., Dia . . . 5 . . . in. to . . . 60 . . . ft., Dia . . . in. to . . . ft.
Casing height above land surface. . . 12 . . . in., weight . . . 125 160 . . . lbs./ft. Wall thickness or gauge No. . . 214 . . .

TYPE OF SCREEN OR PERFORATION MATERIAL:			<u>7 PVC</u>	10 Asbestos-cement
1 Steel	3 Stainless steel	5 Fiberglass	8 RMP (SR)	11 Other (specify)
2 Brass	4 Galvanized steel	6 Concrete tile	9 ABS	12 None used (open hole)

SCREEN OR PERFORATION OPENINGS ARE:		5 Gauzed wrapped	8 <u>Saw cut</u>	11 None (open hole)
1 Continuous slot	3 Mill slot	6 Wire wrapped	9 Drilled holes	
2 Louvered shutter	4 Key punched	7 Torch cut	10 Other (specify)	ft.

SCREEN-PERFORATED INTERVALS: From 23 ft. to 33 ft., From 60 ft. to 70 ft.
From ft. to ft., From ft. to ft.
GRAVEL PACK INTERVALS: From ft. to ft., From ft. to ft.
From ft. to ft., From ft. to ft.

6 GROUT MATERIAL: 1 Neat cement 2 Cement grout 3 ~~Bentonite~~ 4 Other
Grout Intervals: From 0 ft. to 20 ft. From ft. to ft. From ft. to ft.

What is the nearest source of possible contamination:

1 Septic tank	4 Lateral lines	7 Pit privy	10 Livestock pens	14 Abandoned water well
2 Sewer lines	5 Cess pool	8 Sewage lagoon	11 Fuel storage	15 Oil well/Gas well
3 <u>Watertight sewer lines</u>	6 Seepage pit	9 Feedyard	12 Fertilizer storage	16 Other (specify below)
			13 Insecticide storage

Direction from well? WN

How many feet? 50 +

FROM	TO	LITHOLOGIC LOG	FROM	TO	PLUGGING INTERVALS
0	15	Clay			
15	20	fine Sand			
20	23	Clay			
23	32	med Sand			
32	65	Blue Shale			
65	67	Broken Shale - Water			
67	70	Gray Shale			

7] CONTRACTOR'S OR LANDOWNER'S CERTIFICATION: This water well was (1) constructed, (2) reconstructed, or (3) plugged under my jurisdiction and was completed on (mo/day/year) 7-13-01 and this record is true to the best of my knowledge and belief. Kansas Water Well Contractor's Licence No. 180 This Water Well Record was completed on (mo/day/yr) 7-17-01 under the business name of Backhus Drilling by (signature) Paul Backhus