

WATER WELL RECORD

Form WWC-5

Division of Water Resources App. No.


Well ID

MW7

Original Record Correction Change in Well Ust

1 LOCATION OF WATER WELL: County Harvey Fraction SE 1/4 SW 1/4 NW 1/4 SW 1/4 Section Number 18 Township Number T 23 S Range Number R 1 E W

2 WELL OWNER: Last Name: First: Street or Rural Address where well is located (if unknown, distance and direction from nearest town or intersection): If at owner's address, check here: 1804 W 4th St, Newton, KS 67114

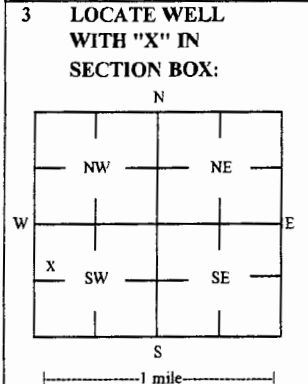

4 DEPTH OF COMPLETED WELL: 20.01 ft Depth(s) Groundwater Encountered: 1) 20.01 ft 2) 3) ft, or 4) Dry Well WELL'S STATIC WATER LEVEL: 16.59 ft

5 Latitude: 38.04679 (decimal degrees) Longitude: 97.37170 (decimal degrees) Horizontal Datum: X WGS 84 NAD 83 NAD 27 Source for Latitude/Longitude: X GPS (unit make/model: ) (WAAS enabled? Yes No) X Land Survey Topographic Map Online Mapper

6 Elevation 1439.60 ft Ground Level X TOC Source X Land Survey GPS Topographic Map Other

7 WELL WATER TO BE USED AS: 1 Domestic: Household Lawn & Garden Livestock Irrigation Feedlot Industrial 5 Public Water Supply: well ID 6 Dewatering: how many wells? 7 Aquifer Recharge: well ID 8 X Monitoring: well ID MW7 9 Environmental Remediation: well ID Air Sparge Soil Vapor Extractor Recovery Injection 10 Oil Field Water Supply: lease 11 Test Hole: well ID Cased Uncased Geotechnical 12 Geothermal: How many bores? a) Closed Loop Horizontal Vertical b) Open Loop Surface Discharge Inj. of Water Other (specify):

Was a chemical/bacteriological sample submitted to KDHE? Yes No X No If yes, date sample was submitted: Water well disinfected? Yes No X No

8 TYPE OF CASING USED: Steel PVC X Other CASING JOINTS: Glued Clamped Welded X Threaded Casing diameter 2 in. to 10.01 ft, Diameter in. to ft, Diameter in. to ft, Casing height above land surface -0.36 in. Weight lbs./ft. Well thickness or gauge No

TYPE OF SCREEN OR PERFORATION MATERIAL: Steel Stainless Steel Fiberglass PVC X Other (Specify) Brass Galvanized Steel Concrete tile None used (open hole)

SCREEN OR PERFORATION OPENINGS ARE: Continuous Slot X Mill Slot Gauze Wrapped Torch Cut Drilled Holes Other (Specify) Louvered Shutter Key Punched Wire Wrapped Saw Cut None (Open Hole)

SCREEN-PERFORATED INTERVALS: From 10.01 ft. to 20.01 ft, From ft. to ft, From ft. to ft, GRAVEL PACK INTERVALS: From 8 ft. to 20.5 ft, From ft. to ft, From ft. to ft,

9 GROUT MATERIAL: Neat cement Cement grout X Bentonite X Other Concrete: 0-0.5' Grout intervals: From 0.5 ft. to 8 ft, From ft. to ft, From ft. to ft,

Nearest source of possible contamination: Septic Tank Lateral Lines Pit Privy Livestock Pens Insecticide Storage Sewer Lines Cess Pool Sewage Lagoon X Fuel Storage Abandoned Water Well Watertight Sewer Lines Seepage Pit Feedyard Fertilizer Storage Oil Well / Gas Well Other (Specify):

Direction from well? S-SE Distance from well? ~15 ft

Table with 6 columns: 10 FROM, TO, LITHOLOGIC LOG, FROM, TO, LITHO. LOG (cont.) or PLUGGING INTERVALS. Rows include 0-0.3 Concrete, 0.3-0.5 Fill sand, 0.5-12 Silty clay, 12-20.5 Sandy clay.

Notes: KDHE ID: Taylor Petroleum #613; U2-040-13913

11 CONTRACTOR'S OR LANDOWNER'S CERTIFICATION: This water well was X constructed, reconstructed, or plugged under my jurisdiction and was completed on (mo-day-year) 8/30/16 and this record is true to the best of my knowledge and belief. Kansas Water Well Contractor's License No 757 This Water Well Record was completed on (mo-day-year) 8/18/16 under the business name of Larsen & Associates, Inc. Signature

# TRITERRA LAND SERVICES

P.O. Box 546  
Clearwater, Kansas 67026

SURVEYING OF ADDITIONAL MONITORING WELLS  
TAYLOR PETROLEUM #613  
NEWTON, KANSAS

The above site is located in Section 18, Township 23 South, Range 1 East of the Sixth Principal Meridian, Harvey County, Kansas. The Southeast corner of Section 18 was assigned coordinates of 00.00 North and 00.00 West.

The vertical control was the previously established control point described as a chiseled 'X' at the southwest corner of the building.

The Latitude and Longitude were recorded from a GPS unit. The site is located on the 7.5' quad map titled "Newton".

ID	NORTH	WEST	LATITUDE	LONGITUDE	ELEVATION
SE CORNER 18-23S-1E	00.00	00.00			
Control Point	1407.27	4843.75	38.04689	97.37178	1440.48
MW-7 SE SW NW SW	1375.98	4849.39	38.04679	97.37170	RIM 1439.96 TOC 1439.60
MW-8 NE NE SE SE 13-23S-1W	1194.13	4962.36	38.04632	97.37212	RIM 1440.10 TOC 1439.48

